

Rice


KANSAS

FORM 51 5M 2-38 TPCO.

Section 24 Township 18 Range 8-W

Well No. #2 Pickerill "A"

Company Continental et al

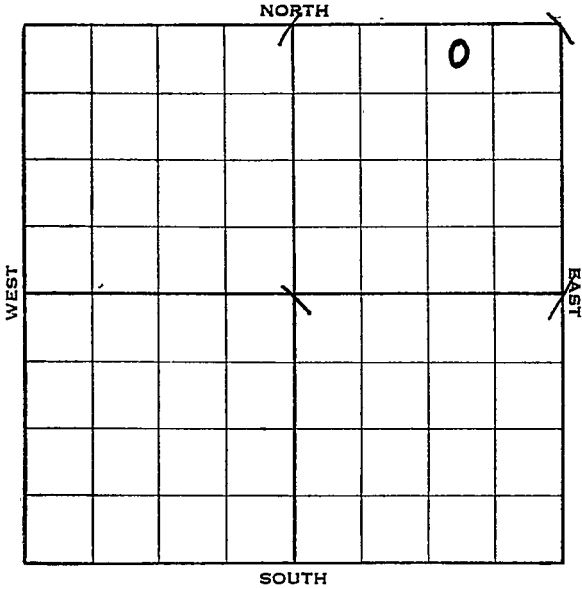

Sec. 24 Twp. 18 R. 8-W


Well No. #2 Pickerill "A" Farm
Continental et al Company

330 Ft. from N. Line

Ft. from S. Line

990 Ft. from E. Line

Ft. from W. Line

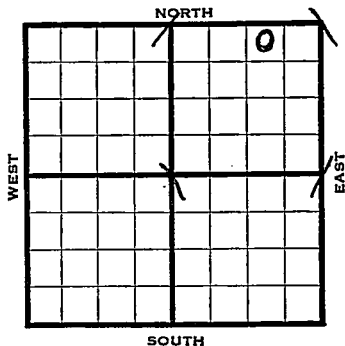

Elev. 1726

1938	REPORT
8/10	Location
8/19	10" - 204', Dlg. 2120'.
8/26	Arb. 3200-02' T. D. S. O.
	7" - 3201'. RUST.
9/2	T. D. 3214'. 3100' oil 3 hrs.
	Bldg. tanks.
9/9	" " "
9/16	Pump 504 oil in 5 hrs.
9/21	7" at 3201'.
	Arb. 3200'.
	T. D. 3214'.
	Potential 2307 bbls.
	COMPLETED

Rice

KANSAS

Map No. 45 Sec. 24 Twp. 18 R. 8WWell No. 2 Pickerill "A"Continental etal

Company

Contractor

FIRST REPORT

NW NE NE

330 Ft. from N. Line

_____ Ft. from S. Line

990 Ft. from E. Line

_____ Ft. from W. Line

SECTION PLAT

			0

Location X

Rig up _____

Drilling and Remarks:

RECORD

Cased _____ in., _____ ft.

Sand _____

Gas _____

Oil _____

Total Depth _____

PRODUCTION

1st 24 hrs. Nat. _____

1st 24 hrs. after shot _____

Gas _____ Cu. Ft.

Dry Hole _____

Abandoned _____

Date

AUG 10 1938 19

H. D. Hatfield Scout

KANSAS

Rice

Map No. 45 Sec. 24 Twp. 18 R. 8WWell No. 2 Pickerill "A"Continental etal Company

Contractor

SECTION PLAT

NW NE NE

330 Ft. from N. Line

_____ Ft. from S. Line

990 Ft. from E. Line

_____ Ft. from W. Line

			0

Location _____

Rig up _____

Drilling and Remarks:

POT 2307

RECORD

Cased 7 in., 3201 ft.Sand Arb 3200

Gas _____

Oil _____

Total Depth 3214

PRODUCTION

1st 24 hrs. Nat. _____

1st 24 hrs. after shot _____

Gas _____ Cu. Ft.

Dry Hole _____

Abandoned _____

Date

SEP 21 1938

19

Halfield
By: *Paul*

Scout