

Map No. KANSAS Sec. 24 Twp. 18 R. 8-W


Well No. 1-Gibson Farm _____
Continental Oil Company _____

_____ Ft. from N. Line

330 Ft. from S. Line

330 Ft. from E. Line

_____ Ft. from W. Line

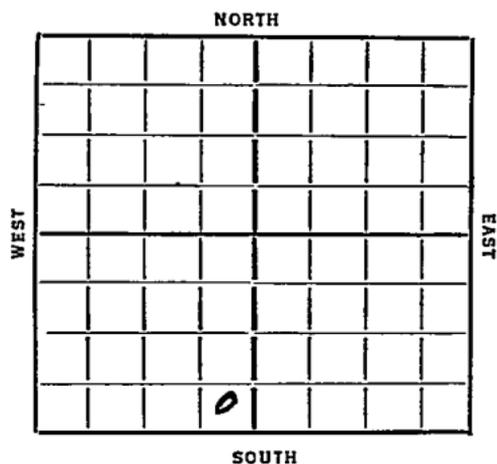

Elev. 1719

Date	REPORT
1936	
4/1	Location
4/10	Building rig.
4/16	Spud 210'
4/23	Drlg. 2400'
4/30	Sil 3161'-7" @ 3165'. T.D. 3167'
	Waiting on cement.
5/7	T.D. 3173'. 1800' oil in 1 hour.
	H.F.O.
5/14	No test.
5/20	/36- Sil. 3161'.
	4000 acid.
	T.D. 3173'.
	1434 bbls.
	COMPLETED

Map No. 45 Sec. 24 Twp. 18 R. 8 W

Well No. 1- Gibson

Continental Oil Company

Contractor

FIRST REPORTS

SECTION PLAT

..... Ft. from N. Line

330 Ft. from S. Line

330 Ft. from E. Line

..... Ft. from W. Line

Location ✓

Rig up

Drilling and Remarks:

RECORD

Cased..... in., ft.

Sand

Gas

Oil

Total Depth

PRODUCTION

1st 24 hrs. Nat.

1st 24 hrs. after shot

Gas..... Cu. Ft.

Dry Hole

Abandoned

Date

4-1-36 192..... **ORVAL MANNSCHRECK** Scout

KANSAS

Map No. 45 Sec. 24 Twp. 18 R. 5WWell No. 1 G. F. GixsonContinental Company

Contractor

SECTION PLAT

_____ Ft. from N. Line

330 Ft. from S. Line330 Ft. from E. Line

_____ Ft. from W. Line

COMPLETED

Location _____

Rig up _____

Drilling and Remarks:

Sil 31614000 acid1434 yk

RECORD

Cased _____ in., _____ ft.

Sand _____

Gas _____

Oil _____

Total Depth 3173

PRODUCTION

1st 24 hrs. Nat. _____

1st 24 hrs. after shot _____

Gas _____ Cu. Ft.

Dry Hole _____

Abandoned _____

Date

MAY 20 1936 19

S. J. LEWIS Scout