


Section 24 Township 18 Range 8-W

Well Number #2 B.B. Ainsworth

Company Continental

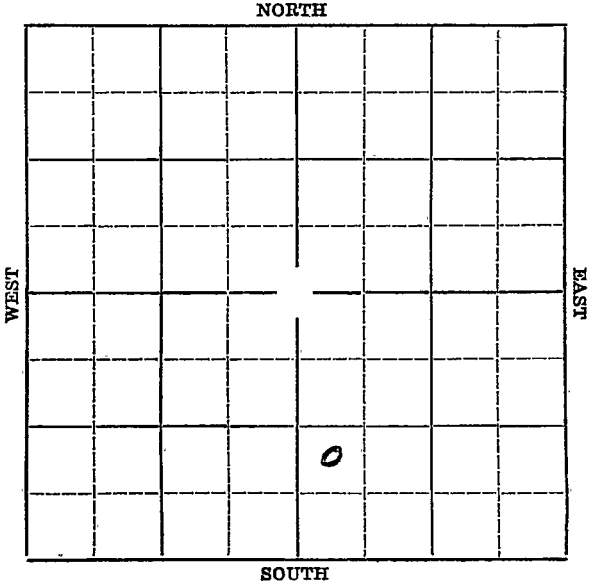

Sec. 24 Twp. 18 R. 8W

Well No. #2 B.B. Ainsworth Farm
Continental Oil. Company


_____ Ft. from N. Line

990' Ft. from S. Line

_____ Ft. from E. Line

330' Ft. from W. Line

Elev. 1721

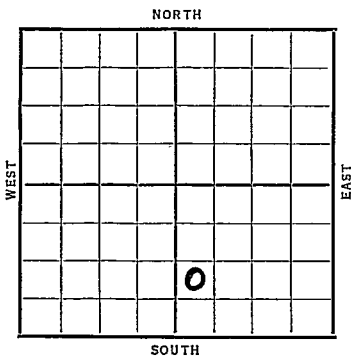

~~1936~~

REPORT

10/14 Location.

10/22 Rig.

10/29 Rig and tools.

11/6 13" 177 Drlg. 1180

11/12 Drlg. 2840

11/19 Sil. 3201'. 7" @ 3204'.

T. D. 3214'. Rust.

11/27---

12/3 3222', 4000 acid. No test.

12/9 Sil. 3201

4000 Acid

Pot. 1330

T.D. 3222'

COMPLETED

KANSAS

Form 26 1M Bks. 2-29

Map No. 45 Sec. 24 Twp. 18 R. 8W

Well No. 2 B.B. Owsen

Continental Company

Contractor

SECTION PLAT

| | | | |
|--|--|---|--|
| | | | |
| | | | |
| | | | |
| | | o | |

_____ Ft. from N. Line

990 Ft. from S. Line

_____ Ft. from E. Line

330 Ft. from W. Line

FIRST REPORT

Location ✓

Rig up _____

Drilling and Remarks:

RECORD

Cased _____ in., _____ ft.

Sand _____

Gas _____

Oil _____

Total Depth _____

PRODUCTION

1st 24 hrs. Nat. _____

1st 24 hrs. after shot _____

Gas _____ Cu. Ft.

Dry Hole _____

Abandoned _____

Date

OCT 14 1936₉

S. J. LEWIS Scout

Map No. 45 Sec. 24 Twp. 18 R. 8W

Well No. 2 B.B. Brinkley

Continental Company

Contractor

SECTION PLAT

| | | | |
|--|--|---|--|
| | | | |
| | | | |
| | | | |
| | | 0 | |

_____ Ft. from N. Line

990 Ft. from S. Line

_____ Ft. from E. Line

330 Ft. from W. Line

COMPLETED

Location _____

Rig up _____

Drilling and Remarks:

Bit 3201
4000 aciol
Pat 1330

RECORD

Cased _____ in., _____ ft.

Sand _____

Gas _____

Oil _____

Total Depth 3222

PRODUCTION

1st 24 hrs. Nat. _____

1st 24 hrs. after shot _____

Gas _____ Cu. Ft.

Dry Hole _____

Abandoned _____

Date

DEC 9 1936 19

S. J. LEWIS Scout