

# KANSAS

Form 51-5M-7-39-Palace


O.W.W.O.

Rice

Section 24 Township 18 Range 8-W

Well No. #2 J. N. ~~Legey~~ <sup>Disque</sup>

Company Continental et al

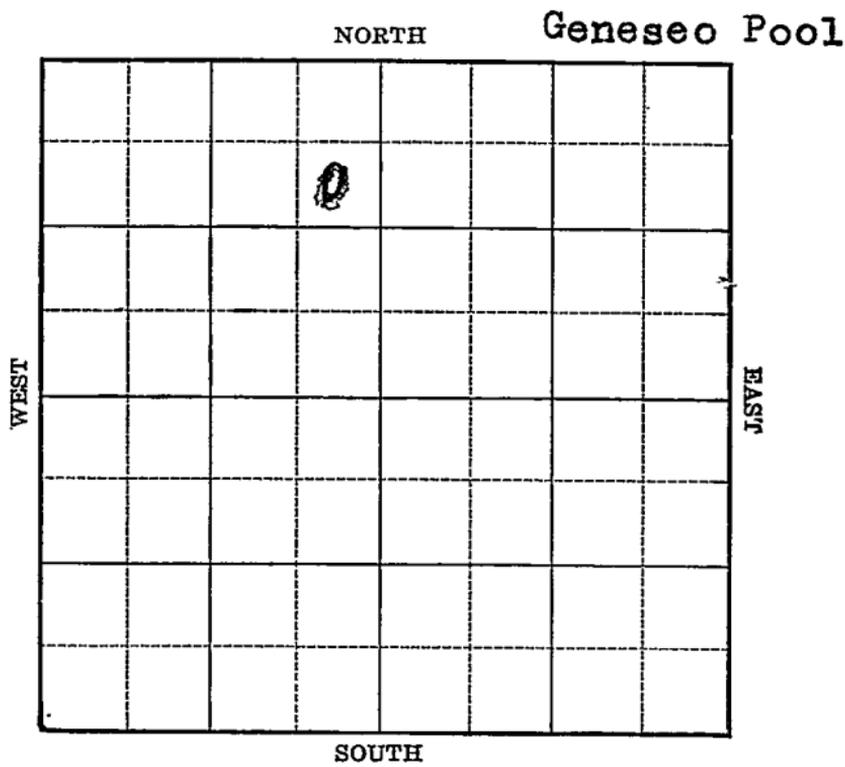

Sec. 24 Twp. 18 R. 8-W

Well No. #2 J. N. ~~Dickey~~ <sup>Disque</sup> Farm

Continental et al Company

(Geneseo)

990 Ft. from N. Line


Ft. from S. Line

330 Ft. from E. Line

Ft. from W. Line

SE NE NW

Elev. 1704

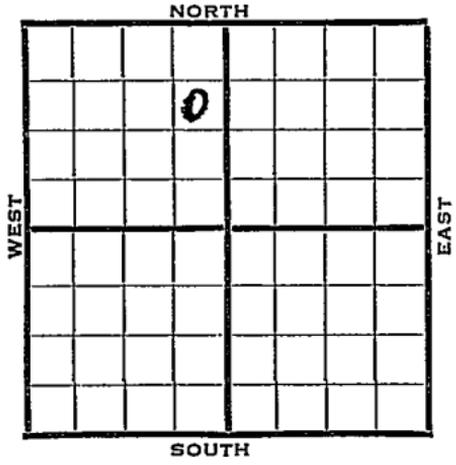

1940	REPORT
3/27	10" - 195' WOC.
4/4	Drilg. 2590'
4/12	Arb. 3178-83' T.D.
	7" - 3179'
4/17	Arb. 3178'
	7" - 3179'
	T.D. 3184'
	1000 acid.
	Echometer potential 15,122 bbls.
	Maximum 3000 bbls.
	<b>COMPLETED</b>
	<b>O.W.W.O.</b>
1952	
11/26	Lans. 2795' Arb. 3178' OTD 3185'
	7" @ 3179' MICT To test Lans.
12/4	PB 3150'
12/11	48/2980-96 36/2952-64 wtr 75/2871-96
	4 BWPB sit Plug 2845 24/2833-47 4
	GWPH 12798-2810 5 GWPH

OVER

#2 Dique

12/18 NR

12/25 NR

1/1 NR

1/8 NR

1/22 NR

1/29 "

2/5 NR

2/12 NR

2/19 NR

2/26 "

3/12 NR

3/19 NR

3/26 NR

4/2 "

4/9 "

4/15 D&A

TD 3185

Lans 2795, Arb. 3178

OTD 3185

7" 3179

PB 3150

48/2980-96, 36/2952-64, B/3 gwph

75/2871-96, B/4 bwph SP 2845

24/2833-42, 4 gwph, perf 2798-2810

5 gwph

D&A

**ABANDONED**

Map No. 45 Sec. 24 Twp. 18 R. 8WWell No. 2 J. N. DickeyContinental etal Company

Contractor

**FIRST REPORT**

SE NE NW

**SECTION PLAT**

	o		

990 Ft. from N. Line

\_\_\_\_\_ Ft. from S. Line

330 Ft. from E. Line

\_\_\_\_\_ Ft. from W. Line

GENESEO POOL

Location \_\_\_\_\_

Rig up \_\_\_\_\_

Drilling and Remarks:

10" - 195

WOC

**RECORD**

Cased \_\_\_\_\_ in., \_\_\_\_\_ ft.

Sand \_\_\_\_\_

Gas \_\_\_\_\_

Oil \_\_\_\_\_

Total Depth \_\_\_\_\_

**PRODUCTION**

1st 24 hrs. Nat. \_\_\_\_\_

1st 24 hrs. after shot \_\_\_\_\_

Gas \_\_\_\_\_ Cu. Ft.

Dry Hole \_\_\_\_\_

Abandoned \_\_\_\_\_

Date

MAR 27 1940 19

S. J. LEWIS Scout

Map No. 45 Sec. 24 Twp. 18 R. 8WWell No. 2 J. N. DickeyContinental etal CompanyCOMPLETED Contractor

SE NE NW

990 Ft. from N. Line       Ft. from S. Line330 Ft. from E. Line       Ft. from W. Line

GENESEO POOL

## SECTION PLAT


Location \_\_\_\_\_

Rig up \_\_\_\_\_

Drilling and Remarks:

*Oil 3178**7" C 3179**1000 Acad**Echometer P & S**15122**Map 12122 2000*

## RECORD

Cased \_\_\_\_\_ in., \_\_\_\_\_ ft.

Sand \_\_\_\_\_

Gas \_\_\_\_\_

Oil \_\_\_\_\_

Total Depth 3184

## PRODUCTION

1st 24 hrs. Nat. \_\_\_\_\_

1st 24 hrs. after shot \_\_\_\_\_

Gas \_\_\_\_\_ Cu. Ft.

Dry Hole \_\_\_\_\_

Abandoned \_\_\_\_\_

Date

APR 17 1940 19

S. J. LEWIS Scout

O.W.W.O.

County Rice State Kansas

Sec. 24 (Blk. Twp.) 18 (Sur. Rge.) SW Map No.

Operator Continental etal.

Well No. 2 Farm Disque

Elev. 1704 Location SW NW NW


990 Ft. From N Line NW

350 Ft. From N Line Quarter

lst. Report NOV 26 1952

Completion O.W.W.O.

Remarks O.W.W.O.

Spudding Date

Drlg. Data

Lens. 2795 Arb. 3178 OTD 3185

7" @ 3179 MICT to test Lens.

~~Continental Oil Co.~~

J. G. McGEHEE

Map No. \_\_\_\_\_ Sec. 24 Twp. 18 R. 8W

Well No. 2 Disque

Continental Oil

Company

**CORRECTION**

Contractor

SE NE NW

SECTION PLAT


990 Ft. from N. Line

\_\_\_\_\_ Ft. from S. Line

330 Ft. from E. Line

\_\_\_\_\_ Ft. from W. Line

**OWVO**

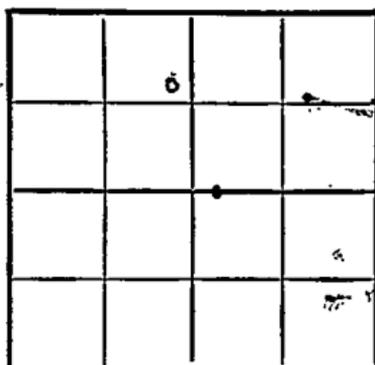

Rice County

Location \_\_\_\_\_

Rig up \_\_\_\_\_

Drilling and Remarks:

**Reported**  
**SW NW NW**

RECORD

Cased \_\_\_\_\_ in., \_\_\_\_\_ ft.

Sand \_\_\_\_\_

Gas \_\_\_\_\_

Oil \_\_\_\_\_

Total Depth \_\_\_\_\_

PRODUCTION

1st 24 hrs. Nat. \_\_\_\_\_

1st 24 hrs. after shot \_\_\_\_\_

Gas \_\_\_\_\_ Cu. Ft.

Dry Hole \_\_\_\_\_

Abandoned \_\_\_\_\_

Date

**OBEC 33** 1952

**J. G. McGEHEE**

Scout

