

O. W. D. D

Rice

KANSAS

FORM 51

NO-RECORD

Section 24 Township 18 Range 8 W

Well No. # 3 J. N. Diskey

Company Continental Oil

NORTH

			0				

WEST

EAST

SOUTH

NO-RECORD

Rice

KANSAS

SEC. W. D. D	TWP.	R.
24	18	8 W ✓

WELL NO. _____

COMPANY # 3 J. N. Diskey FARM

CONTRACTOR Continental Oil


Lohman & Johnson
Geneseo Pool

330 Ft. from N. Line

_____ Ft. from S. Line

330 Ft. from E. Line

_____ Ft. from W. Line

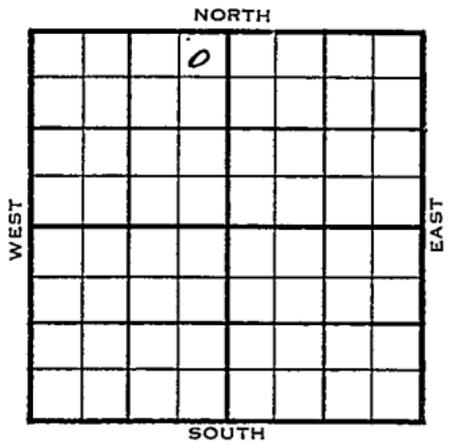

NE NE NW

1954	ELEVATION	REPORT
	1705'	

1/27 **O. W. D. D** **NO-RECORD**

OWDD for SWD
 SWD well. TD 3844'
 Arb. 3175' OTD 3207' 6" @ 3206'
 Sq. perf 3175-83' DC 3192
 Basal sd 3718' 3000 A TD 3844
 Comp. for SWD

FIRST REPORT



ABANDONED

NO-RECORD
O. W. D. D

County Rice State Kansas

Sec. 24 (Blk. Twp.) 18 (Sur. Rge.) 8W Map No.

Operator Continental Oil

Well No. 3 Farm J. N. Diskey

Elev. 1705 Location NE NE NW

			0			
FIRST REPORT						
ABANDONED						

330 Ft. From N Line NW

330 Ft. From E Line Quarter

1st. Report JAN 27 1954

Completion JAN 27 1954

Remarks OWDD for SWD

Lohman & Johnson - Contr.

Spudding Date

Drlg. Data SWD well TD3844 Geneseo Pool

Arb. 3175 OTD 3207 6" @ 3206

sq. perf. 3175-83 DC 3192 Basal sd. 3718

3000 A TD 3844 Comp. for SWD

NO RECORD
NO-RECORD