


Section 24 Township 18 Range 8-W

Well No. #3 W. S. Pickerill "A"

Company Continental et al

NORTH Geneseo Pool

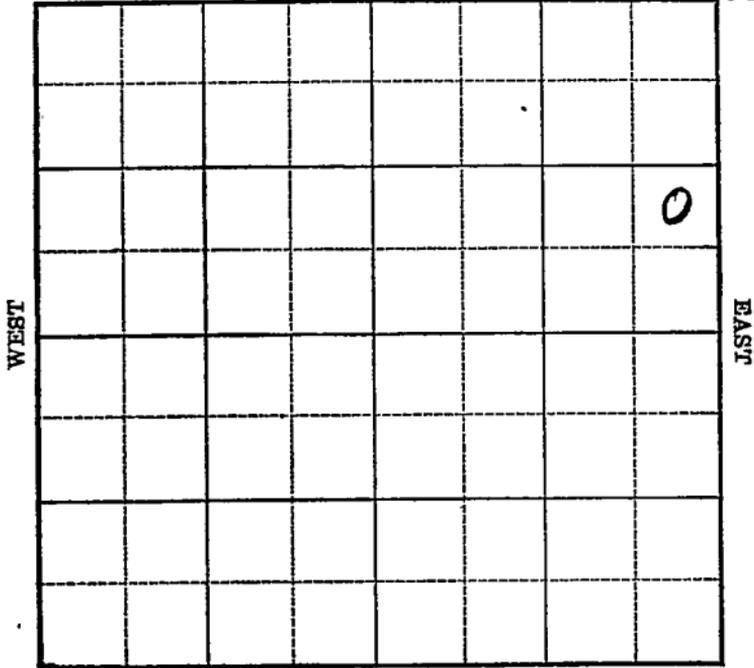

SOUTH

**KANSAS**

Rice

Sec. 24 Twp. 18 R. 8-W

Well No. #3 W. S. Pickerill "A" Farm

Continental et al Company

(Geneseo)


\_\_\_\_\_ Ft. from N. Line

990 Ft. from S. Line

330 Ft. from E. Line

\_\_\_\_\_ Ft. from W. Line

Elev. 1702

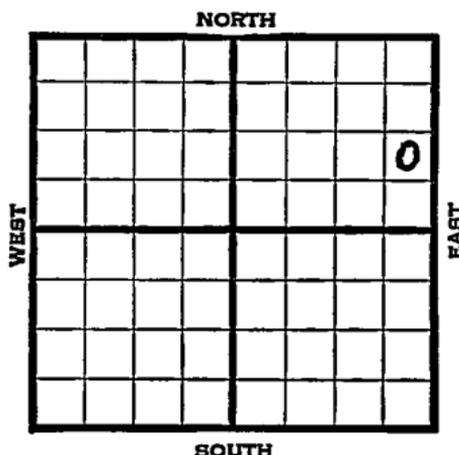

1939	REPORT
6/21	Rotary.
6/29	10" - 223' Drig. 597'
7/6	Drig. 2790'
7/13	Arb. 3126' 7" - 3127'
	T.D. 3138' 1500' oil 1 hour.
	Drilled 3165' 3000' oil.
7/20	T.D. 3180' Pump 233 oil 8 hrs.
	3000 acid. Pump 266 oil 5 hrs.
7/26	Arb. 3126'
	7" - 3127'
	T.D. 3180'
	3000 acid.
	Potential 2274 bbls., pump.
	<b>COMPLETED</b>



Rice

KANSAS

Map No. 45 Sec. 24 Twp. 18 R. 8W

Well No. 3 W. S. Pickerill "A"

Continental etal Company

Contractor

**COMPLETED**

NE SE NE

\_\_\_\_\_ Ft. from N. Line

990 Ft. from S. Line

330 Ft. from E. Line

\_\_\_\_\_ Ft. from W. Line

**GENESEO POOL**

**SECTION PLAT**

			o

Location \_\_\_\_\_

Rig up \_\_\_\_\_

Drilling and Remarks:

*Car 3126.*

*7" @ 3127*

*3000 acid*

*Pump 2274 Pt.*

**RECORD**

Cased \_\_\_\_\_ in., \_\_\_\_\_ ft.

Sand \_\_\_\_\_

Gas \_\_\_\_\_

Oil \_\_\_\_\_

Total Depth 3180

**PRODUCTION**

1st 24 hrs. Nat. \_\_\_\_\_

1st 24 hrs. after shot \_\_\_\_\_

Gas \_\_\_\_\_ Cu. Ft.

Dry Hole \_\_\_\_\_

Abandoned \_\_\_\_\_

Date

JUL 26 1939

19

S. J. LEWIS

Scout