


Section 24 Township 18 Range 8-W

Well No. #5 Ainsworth

Company Cintinental et al

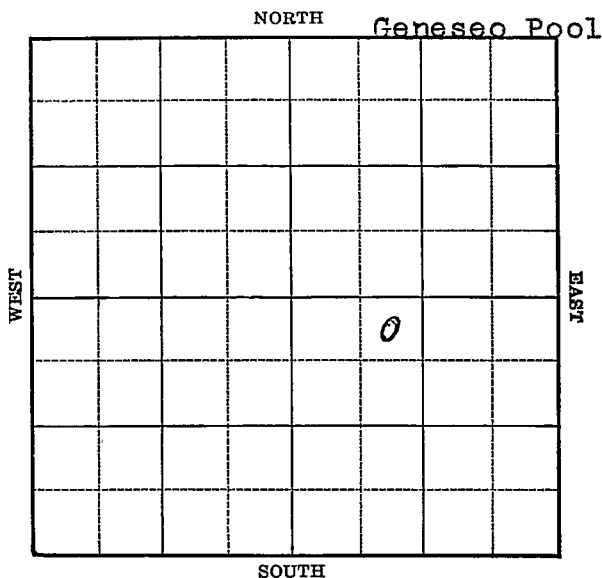

Sec. 24 Twp. 18 R. 8-W

Well No. #5 Ainsworth Farm \_\_\_\_\_

Continental et al Company

(Geneseo)


330 Ft. from N. Line

\_\_\_\_\_ Ft. from S. Line

~~990~~ Ft. from E. Line

990 Ft. from W. Line

Elev. 1705

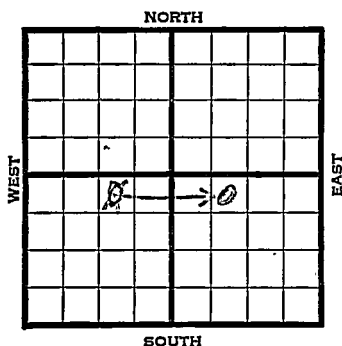

1940	REPORT
10/9	10" - 206' WOC.
10/17	Drlg. 2890'
10/24	Arb. 3117' 6" - 3118'
	Drlg. 3134' 1000' oil.
10/31	T.D. 3180' 3100' oil.
11/6	Arb. 3117'
	6" - 3118'
	T.D. 3180'
	Echometer potential 5135 bbls.
	Maximum 3000 bbls.
	<b>COMPLETED</b>

Map No. \_\_\_\_\_ Sec. 24 Twp. 18 R. 8W

Well No. 5 Ainsworth

Continental etal Company

Contractor

**FIRST REPORT**

NW NE SW

330 Ft. from N. Line

\_\_\_\_\_ Ft. from S. Line

990 Ft. from E. Line

\_\_\_\_\_ Ft. from W. Line

**SECTION PLAT**

	o		

**GENESEO POOL**

Location \_\_\_\_\_

Rig up \_\_\_\_\_

Drilling and Remarks:

10" - 206

WOC

**RECORD**

Cased \_\_\_\_\_ in., \_\_\_\_\_ ft.

Sand \_\_\_\_\_

Gas \_\_\_\_\_

Oil \_\_\_\_\_

Total Depth \_\_\_\_\_

**PRODUCTION**

1st 24 hrs. Nat. \_\_\_\_\_

1st 24 hrs. after shot \_\_\_\_\_

Gas \_\_\_\_\_ Cu. Ft.

Dry Hole \_\_\_\_\_

Abandoned \_\_\_\_\_

Date

OCT 9 1940 19

S. J. LEWIS Scout



Map No. 45 Sec. 24 Twp. 18 R. 8WWell No. 5 AinsworthContinental etal

Company

Contractor

**COMPLETED**

NE NW SE

330 Ft. from N. Line

\_\_\_\_\_ Ft. from S. Line

\_\_\_\_\_ Ft. from E. Line

990 Ft. from W. Line

GENESEO POOL

**SECTION PLAT**

		o	

Location \_\_\_\_\_

Rig up \_\_\_\_\_

Drilling and Remarks:

*Per 3117  
6" @ 3117*

*Echo Per 5135*

**RECORD**

Cased \_\_\_\_\_ in., \_\_\_\_\_ ft.

Sand \_\_\_\_\_

Gas \_\_\_\_\_

Oil \_\_\_\_\_

Total Depth 8180**PRODUCTION**

1st 24 hrs. Nat. \_\_\_\_\_

1st 24 hrs. after shot \_\_\_\_\_

Gas \_\_\_\_\_ Cu. Ft.

Dry Hole \_\_\_\_\_

Abandoned \_\_\_\_\_

Date

NOV 6 1940S. J. LEWIS Scout