KANSAS

Form 51—5M—7-39—Palace


Rice

Section 24 Township 18 Range 8-W

Well No. #5 W. S. Pickerill "A"

Company Continental et al

Geneseo Pool

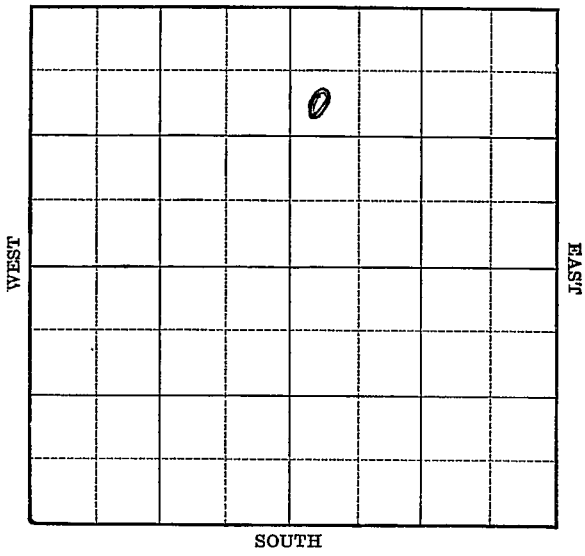

FORM 252-A 5M 4-39 KANSAS Rice

Sec. 24 Twp. 18 R. 8-W

Well No. #5 W. S. Pickerill "A" Farm

Continental et al Company


(Geneseo)

990 Ft. from N. Line

Ft. from S. Line

Ft. from E. Line

330 Ft. from W. Line

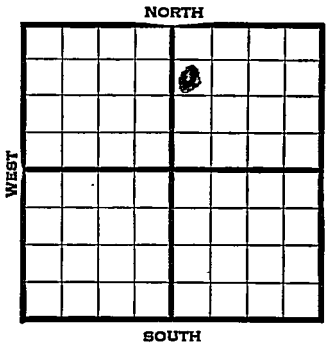

Elev. 1709

1940	REPORT
5/8	Derrick Corners
5/16	10" - 205' WOC.
5/23	" " "
5/29	Arb. 3162-65' T.D.
	7" - 3164' C.O.
6/5	Arb. 3162'
	7" - 3164'
	T.D. 3180'
	Echometer potential 2061 bbls.
	COMPLETED

Form 26—200 Bks.—1-40—Palace Rice KANSAS

Map No. 45 Sec. 24 Twp. 18 R. 8W

Well No. 5 W. S. Pickerill "A"

Continental etal Company

Contractor

FIRST REPORT

SW NW NE

990 Ft. from N. Line


Ft. from S. Line

Ft. from E. Line

330 Ft. from W. Line

GENESEO POOL

SECTION PLAT

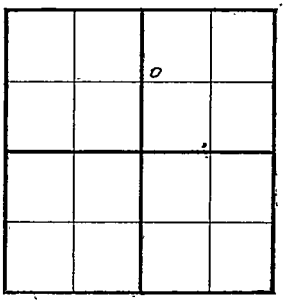

Location

Rig up

Drilling and Remarks:

Derrick Corners

RECORD

Cased in., ft.

Sand

Gas

Oil

Total Depth

PRODUCTION

1st 24 hrs. Nat.

1st 24 hrs. after shot

Gas Cu. Ft.

Dry Hole

Abandoned

Date

MAY 8 1940 19

S. J. LEWIS Scout

Form 26—200 Bks.—1-40—Palace Rice KANSAS

Map No. 45 Sec. 24 Twp. 18 R. 8W

Well No. 5 W. S. Pickerill "A"

Continental etal Company

Contractor

COMPLETED

SW NW NE

990 Ft. from N. Line


Ft. from S. Line

Ft. from E. Line

330 Ft. from W. Line

GENESEO POOL

SECTION PLAT

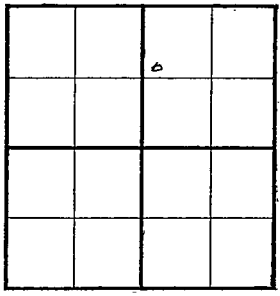

Location

Rig up

Drilling and Remarks:

Cr 3162

7" @ 3164

Echo meter Pot.

2661

RECORD

Cased in., ft.

Sand

Gas

Oil

Total Depth 3180

PRODUCTION

1st 24 hrs. Nat.

1st 24 hrs. after shot

Gas Cu. Ft.

Dry Hole

Abandoned

Date

JUN 5 1940 19

S. J. LEWIS Scout