

# KANSAS

Rice


FORM 51 5M 4-41 PETROL

Section 24 Township 18 Range 8-W

Well No. #6 Gibson

Company Continental et al

Geneseo Pool

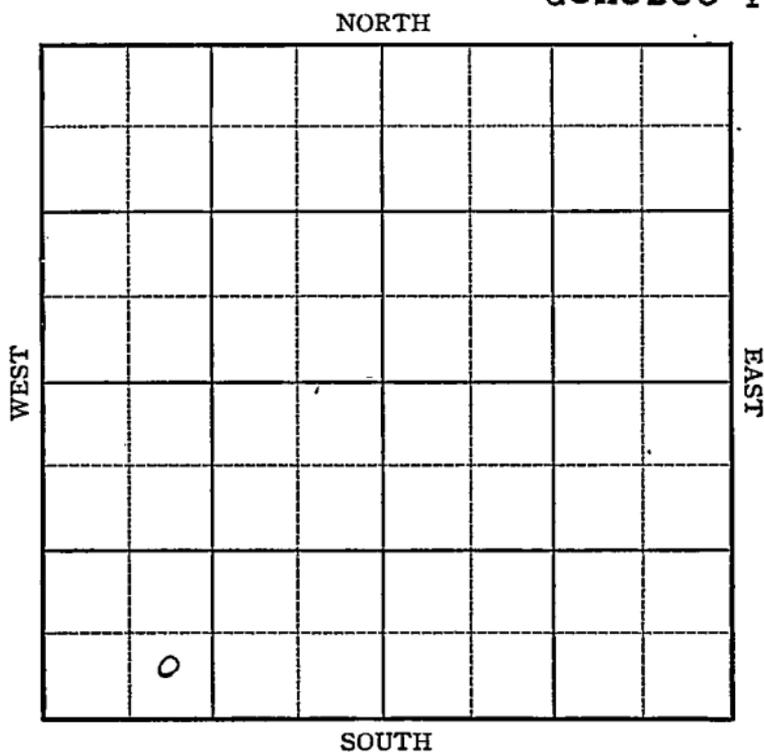

Sec. 24 Twp. 18 R. 8-W

Well No. #6 Gibson Farm

Continental et al Company

(Geneseo)


         Ft. from N. Line

330 Ft. from S. Line

         Ft. from E. Line

990 Ft. from W. Line

Elev. 1739

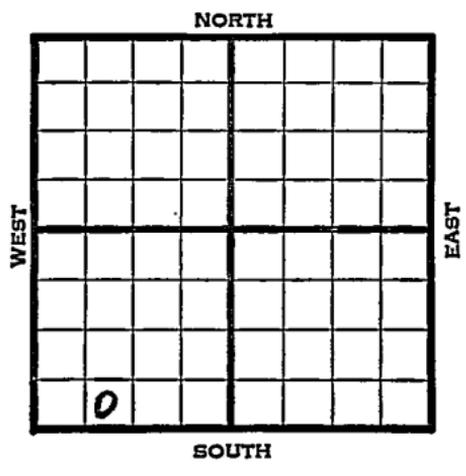

1941	REPORT
4/30	Derrick.
5/8	10" - 202' Drlg. 2329'
5/15	Arb. 3214-29' T.D. 6" - 3215'
	RUST.
5/21	Arb. 3214'
	6" - 3215'
	T.D. 3229'
	Echometer potential 2919 bbls.
	40.1 Gravity
	<b>COMPLETED</b>



Map No. 95 Sec. 24 Twp. 18 R. 8W

Well No. 6 Gibson

Continental etal Company

COMPLETED Contractor

SE SW SW

SECTION PLAT

\_\_\_\_\_ Ft. from N. Line

330 Ft. from S. Line

\_\_\_\_\_ Ft. from E. Line

990 Ft. from W. Line


GENESEO POOL

Location \_\_\_\_\_

Rig up \_\_\_\_\_

Drilling and Remarks:

*Core 3214*  
*6" @ 3215*  
*Echit P 2919*  
  
*40' Gr.*

RECORD

Cased \_\_\_\_\_ in., \_\_\_\_\_ ft.

Sand \_\_\_\_\_

Gas \_\_\_\_\_

Oil \_\_\_\_\_

Total Depth 3229

PRODUCTION

1st 24 hrs. Nat. \_\_\_\_\_

1st 24 hrs. after shot \_\_\_\_\_

Gas \_\_\_\_\_ Cu. Ft.

Dry Hole \_\_\_\_\_

Abandoned \_\_\_\_\_

Date

MAY 21 1941

S. J. LEWIS Scout