

KANSAS

Form 51-5M-7-40-Palace

Rice

Section 24 Township 18 Range 8-W

Well No. #7 Ainsworth

Company Continental et al

NORTH Geneseo Pool

				0			

WEST

EAST

SOUTH

Sec. 24 Twp. 18 R. 8-W

Well No. #7 Ainsworth Farm

Continental et al Company

(Gen eseo)


990 Ft. from N. Line

_____ Ft. from S. Line

_____ Ft. from E. Line

330 Ft. from W. Line

Elev. 1707

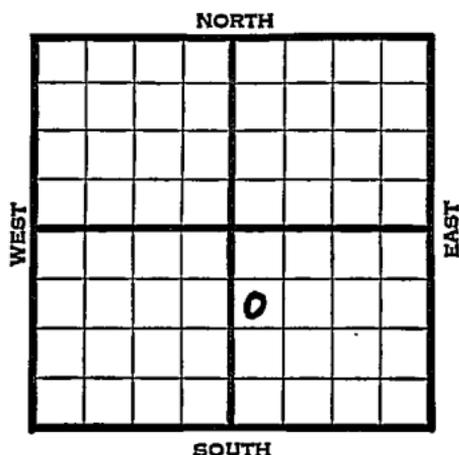

1941	REPORT
2/26	Derrick.
3/6	9" - 195' WOC.
3/13	Drilg. 3175'
3/20	Arb. 3169-87' T.D.
	6" - 3170' 3000' oil.
3/26	Arb. 3169'
	6" - 3170'
	T.D. 3187'
	2000 acid.
	Echometer potential 2538 bbls.
	40.1 Gravity
	COMPLETED

Map No. 45 Sec. 24 Twp. 18 R. 8WWell No. 7 AinsworthContinental etal CompanyFIRST REPORT Contractor

SW NW SE

990 Ft. from N. Line

_____ Ft. from S. Line

_____ Ft. from E. Line

330 Ft. from W. Line

GENESEO POOL

SECTION PLAT

Location _____

Rig up _____

Drilling and Remarks:

Derrick

RECORD

Cased _____ in., _____ ft.

Sand _____

Gas _____

Oil _____

Total Depth _____

PRODUCTION

1st 24 hrs. Nat. _____

1st 24 hrs. after shot _____

Gas _____ Cu. Ft.

Dry Hole _____

Abandoned _____

Date

FEB 26 1941 19S. J. LEWIS Scout

Map No. 45 Sec. 24 Twp. 18 R. 8WWell No. 7 Ainsworth

Continental etal Company

Contractor

COMPLETED

SW NW SE

990 Ft. from N. Line

_____ Ft. from S. Line

_____ Ft. from E. Line

330 Ft. from W. Line

GENESEO POOL

SECTION PLAT

		o	

Location _____

Rig up _____

Drilling and Remarks:

*Cor. 3169**6" C 3170**2000 acid**Echo Pot 2538**40 L Gr.*

RECORD

Cased _____ in., _____ ft.

Sand _____

Gas _____

Oil _____

Total Depth 3187

PRODUCTION

1st 24 hrs. Nat. _____

1st 24 hrs. after shot _____

Gas _____ Cu. Ft.

Dry Hole _____

Abandoned _____

Date

MAR 26 1941 19

S. J. LEWIS Scout