

Rice

18

8W

Sec. 24 Twp. R.

Well No. #7 Gibson Farm

Continental Oil Company

Lohman & Johnson Contractor


Ft. from N. Line

990 Ft. from S. Line

Ft. from E. Line

330 Ft. from W. Line

NW SW SW

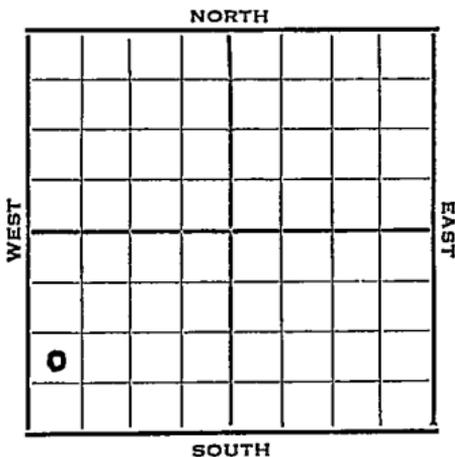

L953 Elev. 1736' REPORT

2/18 Spud 2-10-53
10" @ 364
Drlg. 2740

2/25 Spud 2-10-53 D & A TD 3270
10" @ 364 Heeb 2670 Br lime 2793
Lans 2829
DST 2852-59 open 1 hr. rec 12' SOCM O#
B KC 3135 Cong 3173 Arb. 3230
DST 3231-39 open 1 hr. rec 30' mud
1920' SW 935# TD 3270
D & A

ABANDONED

