

KANSAS


Form 51-5M-7-40-Palace

Rice

Section 24 Township 18 Range 8-W

Well No. #7 Pickerill "A"

Company Continental et al

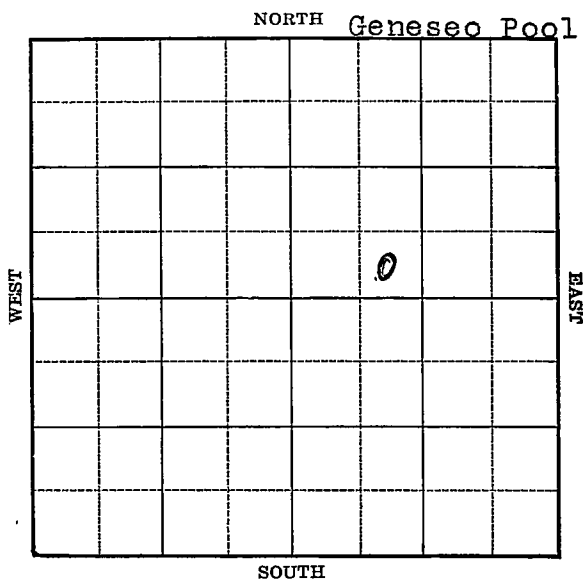

KANSAS

Rice


Sec. 24 Twp. 18 R. 8-WWell No. #7 Pickerill "A" FarmContinental et al Company

(Geneseo)

Ft. from N. Line

330 Ft. from S. Line

Ft. from E. Line

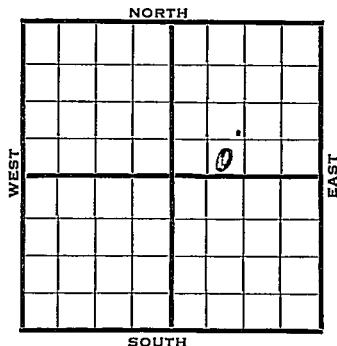990 Ft. from W. Line

Elev. 1700

1940

REPORT

8/14 10" - 217' WOC.

8/22 Drlg. 2590'

8/29 Arb. 3157-69' T.D. 7" - 3159'

RUST.

9/5 T.D. 3173' 3100' oil.

Pump 143 bbls. 4 hours.

9/11 Arb. 3157'

7" - 3159'

T.D. 3173'

Echometer potential 4894 bbls.

Maximum 3000 bbls.

COMPLETED

Map No. _____ Sec. 24 Twp. 18 R. 8WWell No. 7 Pickerill "A"Continental etal

Company

Contractor

SE SW NE

_____ Ft. from N. Line


330 Ft. from S. Line

_____ Ft. from E. Line

990 Ft. from W. Line

GENESEO POOL

SECTION PLAT

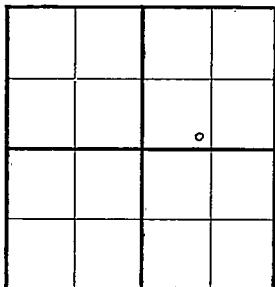

Location _____

Rig up _____

Drilling and Remarks:

10" - 217WOC

RECORD

Cased _____ in., _____ ft.

Sand _____

Gas _____

Oil _____

Total Depth _____

PRODUCTION

1st 24 hrs. Nat. _____

1st 24 hrs. after shot _____

Gas _____ Cu. Ft.

Dry Hole _____

Abandoned _____

Date

AUG 14 194019S. J. LEWIS Scout

Map No. 45 Sec. 24 Twp. 18 R. 8WWell No. 7 Pickerill "A"Continental etal Company

Contractor

COMPLETED

SE SW NE

 Ft. from N. Line330 Ft. from S. Line Ft. from E. Line990 Ft. from W. Line

GENESEO POOL

SECTION PLAT

Location Rig up

Drilling and Remarks:

*CR 83157**7" @ 3159**Echometer Pot**4894**Max 3000***RECORD**Cased in., ft.Sand Gas Oil Total Depth 3123**PRODUCTION**1st 24 hrs. Nat. 1st 24 hrs. after shot Gas Cu. Ft.Dry Hole Abandoned

Date

SEP 11 1940 19 S. J. LEWIS Scout