

KANSAS

Form 51-5M-7-39-Palace


Rice

Section 24 Township 18 Range 8-W

Well No. #4 W. S. Pickerill "A"

Company Continental et al

NORTH Geneseo Pool

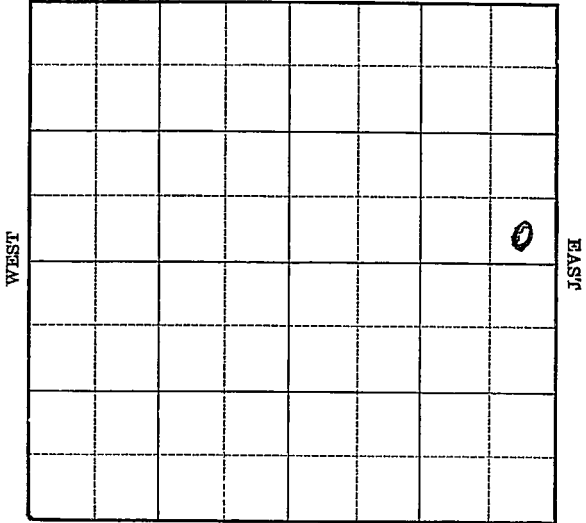

SOUTH

Sec. 24 Twp. 18 R. 8-W

Well No. #4 W. S. Pickerill "A" Farm

Continental et al Company

(Gemeseo)


_____ Ft. from N. Line

330 Ft. from S. Line

330 Ft. from E. Line

_____ Ft. from W. Line

Elev. 1694

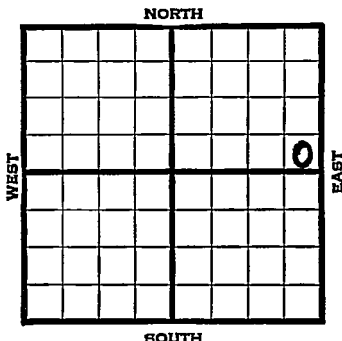

| 1939 | REPORT |
|-------|-------------------------------|
| 8/30 | Location |
| 9/7 | Derrick. |
| 9/14 | " |
| 9/21 | 10" - 207' Drlg. 1330' |
| 9/28 | Arb. 3087' T.D. 3089' Run 7". |
| 10/5 | 7" - 3088' Drlg. 3123' |
| | 2900' oil. |
| 10/12 | T.D. 3174' H.F.O. Run tubing. |
| | |
| 10/18 | Arb. 3087' |
| | 7" - 3088' |
| | T.D. 3174' |
| | Pump 2113 bbls., potential. |
| | |
| | COMPLETED |
| | |
| | |
| | |
| | |
| | |
| | |

Map No. 45 Sec. 24 Twp. 18 R. 8WWell No. H. H. S. Pickens "A"Continental & Co Company

Contractor

SENE
FIRST REPORT

SECTION PLAT

| | | | |
|--|--|--|---|
| | | | |
| | | | o |
| | | | |
| | | | |

_____ Ft. from N. Line

330 Ft. from S. Line330 Ft. from E. Line

_____ Ft. from W. Line

*Genesee Park*Location ✓

Rig up _____

Drilling and Remarks:

RECORD

Cased _____ in., _____ ft.

Sand _____

Gas _____

Oil _____

Total Depth _____

PRODUCTION

1st 24 hrs. Nat. _____

1st 24 hrs. after shot _____

Gas _____ Cu. Ft.

Dry Hole _____

Abandoned _____

Date

AUG 30 1939 19

S. J. LEWIS

Scout

Rice

KANSAS

Map No. 45 Sec. 24 Twp. 18 R. 8W

Well No. 4 W. S. Pickerill "A"

Continental etal

Company

Contractor

COMPLETED

SE NE

_____ Ft. from N. Line

330 Ft. from S. Line

330 Ft. from E. Line

_____ Ft. from W. Line

SECTION PLAT

| | | | |
|--|--|--|---|
| | | | |
| | | | |
| | | | o |
| | | | |

GENESEO POOL

Location _____

Rig up _____

Drilling and Remarks:

Cor. 3087

7" @ 3088.

Pump 2113 P.T.

RECORD

Cased _____ in., _____ ft.

Sand _____

Gas _____

Oil _____

Total Depth 3174

PRODUCTION

1st 24 hrs. Nat. _____

1st 24 hrs. after shot _____

Gas _____ Cu. Ft.

Dry Hole _____

Abandoned _____

Date

OCT 18 1939 19

S. J. LEWIS

Scout