

KANSAS


Rice

Form 51—5M—7-40—Palace

Section 24 Township 18 Range 8-W


Well No. 6 Ainsworth

Company Continental et al

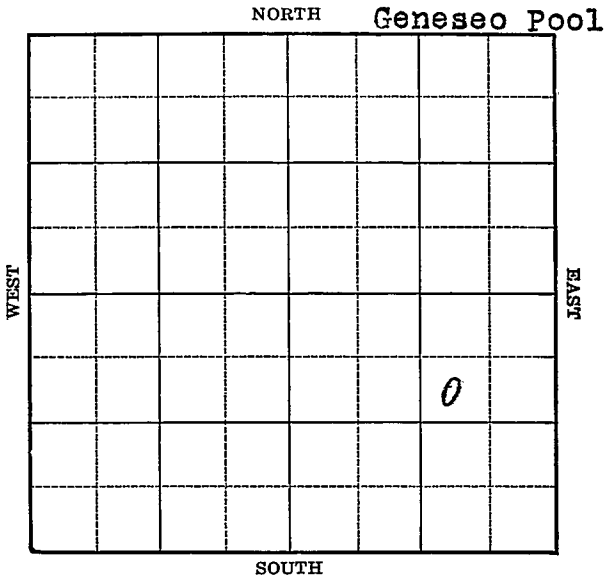

Sec. 24 Twp. 18 R. 8-WWell No. #6 Ainsworth FarmContinental et al Company
(Geneseo)990 Ft. from N. Line Ft. from S. Line990 Ft. from E. Line Ft. from W. Line

Elev. 1718

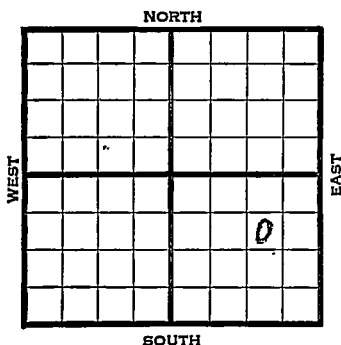

1941

REPORT

1/8

Location

1/16

10" - 208' Drlg. 2102'

1/23

Arb. 3124-31' T.D. 6" - 3125'

RUST.

1/29

T.D. 3198' Swab 108 oil 2 hrs.

2/5

Arb. 3124'

6" - 3125'

T.D. 3198'

Echometer potential 1,600,000

Maximum 3000 bbls.

40.3 Gravity

COMPLETED

Map No. 45 Sec. 24 Twp. 18 R. 8WWell No. 6 AinsworthContinental etal

Company

Contractor

FIRST REPORT**SECTION PLAT**

SW NE SE

990 Ft. from N. Line Ft. from S. Line990 Ft. from E. Line Ft. from W. Line

GENESEO POOL

Location XRig up

Drilling and Remarks:

RECORDCased in., ft.Sand Gas Oil Total Depth **PRODUCTION**1st 24 hrs. Nat. 1st 24 hrs. after shot Gas Cu. Ft.Dry Hole Abandoned

Date

JAN 8 1941 19

S. J. LEWIS Scout


Map No. 45 Sec. 24 Twp. 18 R. 8WWell No. 6 AinsworthContinental etal Company**COMPLETED** Contractor

SECTION PLAT

SW NE SE

990 Ft. from N. Line Ft. from S. Line990 Ft. from E. Line Ft. from W. Line

GENESEO POOL

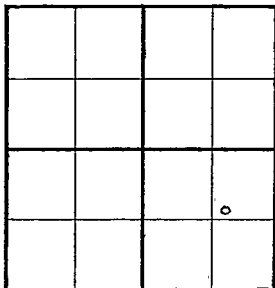Location Rig up

Drilling and Remarks:

*Ar 83124**6" @ 3125'**Ec ho P 81,600,000**Max 3000**40.3 Gr.*

RECORD

Cased in., ft.Sand Gas Oil Total Depth 3197

PRODUCTION

1st 24 hrs. Nat. 1st 24 hrs. after shot Gas Cu. Ft.Dry Hole Abandoned

Date

FEB 5 1941 19

G. J. LEWIS

Scout