
Rice.

Form 51—5M—5-34—Palace

Map No. KANSAS Sec. 25 Twp. 18 R. 8 W

Well No. 1 Ainsworth Farm

Continental Oil Company

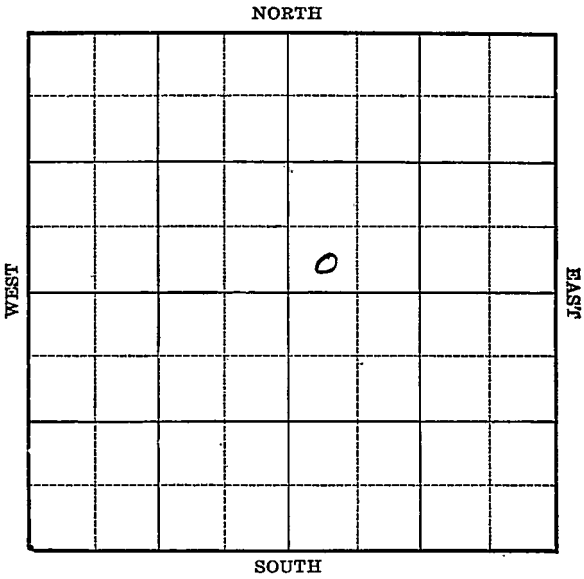

Location

Drilling Remarks

Rig Up

Drilling Remarks

RECORD

Cased ____ in. ____ ft.

Sand

Gas

Oil

Total Depth

PRODUCTION

1st 24 hrs. Nat.

1st 24 hrs. after shot

Gas ____ cu. ft.

Dry Hole

Abandoned


Rice

Form 252-A
5M 4-32 MPC

Map No. KANSAS Sec. 25 Twp 18 R. 8 W

Well No. 1 Ainsworth Farm

Continental Oil Company

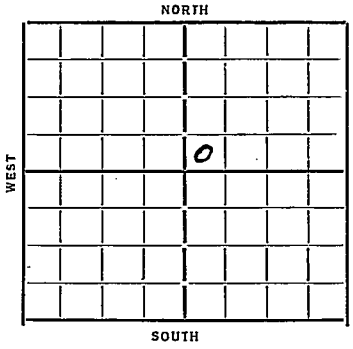

_____ Ft. from N. Line

336 Ft. from S. Line

_____ Ft. from E. Line

330 Ft. from W. Line

Date 1934	REPORT El. 1742
7/25	Location
8/2	Bldg. Rot. Rig
8/9	Dlg 565
8/16	" 2035
8/23	" 2810 S.O. 2795 S.O. 2803
8/30	K.C. 2795 Saturated Core 2875-96 T Sil +6" 3132 TD 3135 S.O. Rust
9/6	3148 TD Swab 21 Bbls oil per hr Set liner
9/12	Siliceous 3132 TD 3172 1598 Bbls.
	COMPLETED

Form 26—1M Bks.—2-29

KANSAS

Map No. 45 Sec. 25 Twp. 18 R. 8W

Well No. 1 - Tinsworth

Continental Oil Company

Contractor

FIRST REPORTS


Ft. from N. Line

330 Ft. from S. Line

Ft. from E. Line

330 Ft. from W. Line

SECTION PLAT

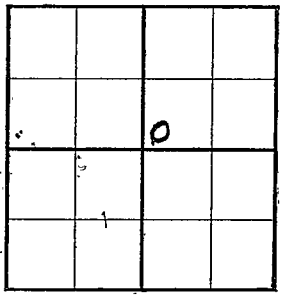

Location ✓

Rig up

Drilling and Remarks:

RECORD

Cased in., ft.

Sand

Gas

Oil

Total Depth

PRODUCTION

1st 24 hrs. Nat.

1st 24 hrs. after shot

Gas Cu. Ft.

Dry Hole

Abandoned

Date

7-25-37 19

ORVAL MANNSCHRECK Scout

Form 26—1M Bks.—2-29

Rice KANSAS

Map No. 45 Sec. 25 Twp. 18 R. 8W


Well No. 1- Ainsworth

Continental Oil Company

Contractor

COMPLETED

SECTION PLAT

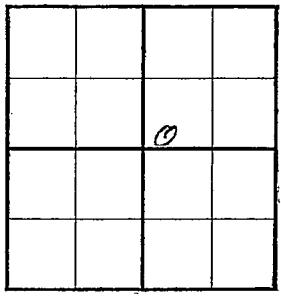

____ Ft. from N. Line

330 Ft. from S. Line

____ Ft. from E. Line

330 Ft. from W. Line

Location ____

Rig up ____

Drilling and Remarks:

1598 bbls

RECORD

Cased ____ in., ____ ft.

Sand Siliceous 3132

Gas ____

Oil ____

Total Depth 3172

PRODUCTION

1st 24 hrs. Nat. ____

1st 24 hrs. after shot ____

Gas ____ Cu. Ft.

Dry Hole ____

Abandoned ____

Date

9-12-37 19

ORVAL MANNSCHRECK Scout