

Rice

Map No. KANSAS Sec. 25 Twp. 18 R. 8^w

Well No. 1 ~~John Lansing~~ Bennett Farm


Continental Empire & Shell Company
etal

330 Ft. from N. Line

660 Ft. from S. Line

660 Ft. from E. Line

330 Ft. from W. Line

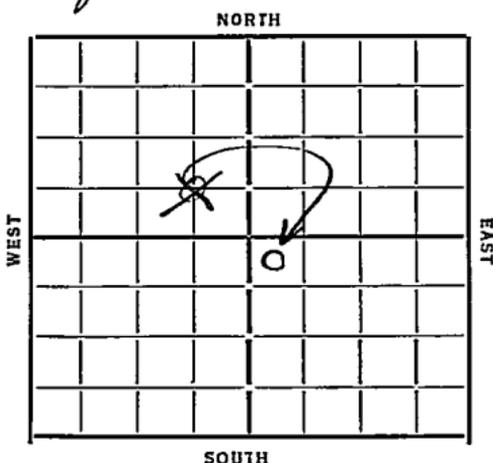

Date 1923

REPORT

12/24 Location

1/11 — 1/17 — 1/24 — 1/31 —

2/7 — 2/14 — 2/23 — 3/1 —

3/8 — 3/15 — 3/23 — 3/29 —

4/5 — 4/12 —

4/19 Rot Rig

4/26 —

5/3 dly 1034 12 1/2" 169

5/10 dly 2435 (5/25 - 26" 3130)

5/18 Lansing 2785 Simpson 3128

Siliceous 3132 TD 3135

5/29 Top Siliceous line 3132

300 feet oil in hole

Drilled to TD 3156

2300 feet oil in hole swabbing

& flowing around 200 Bbls

per day. (Telephone)

5/29 2nd Report

Swabbed to Bottom set one

hour filled 500 feet oil

(Telegram)

- OVER -

5/31 TD 3172

2800 feet oil 8 hrs
Erecting tanks to swab
(Telegram)

6/5 Swabbed 914 Bbls
24 hrs. (Telegram)

6/14 — 6/21 — 6/28 —

7/5 —

7/11 1113 Bbls Natural
1000 acid
1294 Bbls Pot.

COMPLETED

Map No. 45 Sec. 25 Twp. 18 R. 8W

Well No. 1- J. O. Lansing

Continental, Empire + Shell Company

Contractor

FIRST REPORTS

Ft. from N. Line

660 Ft. from S. Line

660 Ft. from E. Line

Ft. from W. Line

SECTION PLAT

	0		

Location ✓

Rig up

Drilling and Remarks:

RECORD

Cased.....in.,ft.

Sand.....

Gas.....

Oil.....

Total Depth.....

PRODUCTION

1st 24 hrs. Nat.....

1st 24 hrs. after shot.....

Gas.....Cu. Ft.

Dry Hole.....

Abandoned.....

Date

12-27-33 192

O. Manschreck
Scout

Map No. 45 Sec. 25 Twp. 18 R. 8W

Well No. 1-Bennett

Continental etal Company

Contractor

CORRECTION

330 Ft. from N. Line

_____ Ft. from S. Line

_____ Ft. from E. Line

330 Ft. from W. Line

CORRECTION

SECTION PLAT

		0	

Location _____

Rig up _____

Drilling and Remarks:

*formerly Reported
center S E NW
and #1-g.o.
soning*

RECORD

Cased _____ in., _____ ft.

Sand _____

Gas _____

Oil _____

Total Depth _____

PRODUCTION

1st 24 hrs. Nat. _____

1st 24 hrs. after shot _____

Gas _____ Cu. Ft.

Dry Hole _____

Abandoned _____

CORRECTION

Date

4-18-37 19

ORVAL MANNSCHRECK

Scout

Map No. 45 Sec. 25 Twp. 18 R. 8W

Well No. 1 - Bennett

Continental et al Company

Contractor

COMPLETED

SECTION PLAT

		0	

330 Ft. from N. Line

_____ Ft. from S. Line

_____ Ft. from E. Line

330 Ft. from W. Line

Location _____

Rig up _____

Drilling and Remarks:

*1113 bbls Natural
1000 acid
1294 bbls pot.*

RECORD

Cased _____ in., _____ ft.

Sand _____

Gas _____

Oil _____

Total Depth _____

PRODUCTION

1st 24 hrs. Nat. _____

1st 24 hrs. after shot _____

Gas _____ Cu. Ft.

Dry Hole _____

Abandoned _____

Date

7-11-34 19

ORVAL MANNSCHRECK

Scout