



Rice

Map No. KANSAS Sec. 25 Twp. 18 R. 8<sup>w</sup>


Well No. 1 Kimple Farm  
Continental etel Company

\_\_\_\_\_ Ft. from N. Line

330 Ft. from S. Line

330 Ft. from E. Line

\_\_\_\_\_ Ft. from W. Line

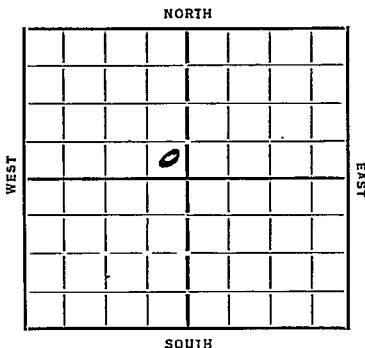

Date 1934

REPORT

9/26 Material  
10/4 12" 180  
10/11 dly 700  
10/18 " 2500  
10/25 6" 3149 Rust  
11/1 Lansing 2785 Silicious 3148  
Simpson 3145 TD 3149 Rust  
11/8 dly plug shoot 80 Bbls 2 hrs.  
11/15 TD 3175 shoot 65 Bbls P.A.  
Nat.  
11/21 Sil 3148 TD 3175  
1896 Bbls Nat.

COMPLETED

Map No. 45 Sec. 25 Twp. 18 R. 8W

Well No. 1-Kimple

Continental etal Company

Contractor

SECTION PLAT


\_\_\_\_\_ Ft. from N. Line

330 Ft. from S. Line

330 Ft. from E. Line

\_\_\_\_\_ Ft. from W. Line

FIRST REPORTS

Location \_\_\_\_\_

Rig up \_\_\_\_\_

Drilling and Remarks:

*Material*

RECORD

Cased \_\_\_\_\_ in., \_\_\_\_\_ ft.

Sand \_\_\_\_\_

Gas \_\_\_\_\_

Oil \_\_\_\_\_

Total Depth \_\_\_\_\_

PRODUCTION

1st 24 hrs. Nat. \_\_\_\_\_

1st 24 hrs. after shot \_\_\_\_\_

Gas \_\_\_\_\_ Cu. Ft.

Dry Hole \_\_\_\_\_

Abandoned \_\_\_\_\_

Date

9-26-37 19

Map No. 45 Sec. 25 Twp. 18 R. 8W

Well No. 1-Kimple

Continental Oil Company

Contractor

**COMPLETED**

**SECTION PLAT**


\_\_\_\_\_ Ft. from N. Line

330 Ft. from S. Line

330 Ft. from E. Line

\_\_\_\_\_ Ft. from W. Line

Location \_\_\_\_\_

Rig up \_\_\_\_\_

Drilling and Remarks:

1896 fbs  
nat.

**RECORD**

Cased \_\_\_\_\_ in., \_\_\_\_\_ ft.

Sand Sil 3148

Gas \_\_\_\_\_

Oil \_\_\_\_\_

Total Depth 3175

**PRODUCTION**

1st 24 hrs. Nat. \_\_\_\_\_

1st 24 hrs. after shot \_\_\_\_\_

Gas \_\_\_\_\_ Cu. Ft.

Dry Hole \_\_\_\_\_

Abandoned \_\_\_\_\_

Date

**ORVAL MANNSCHRECK**

11-21-37 19

Scout