


Section 25 Township 18 Range 8-W

Well Number 2-Ainsworth

Company Continental

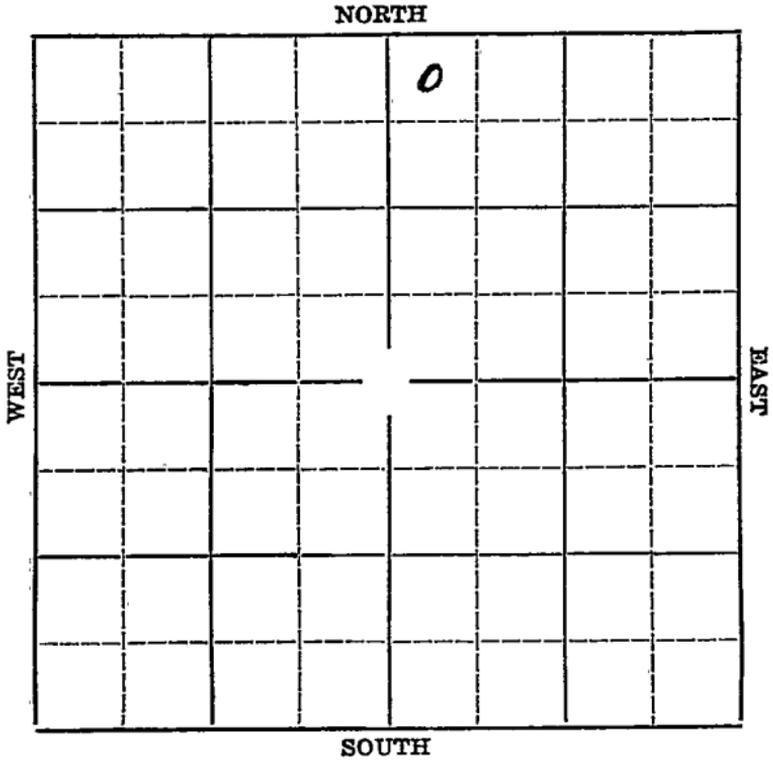

Map No. 45 Sec. 25 Twp. 18 R. SW

Well No. 2. Pinnawith

Continental Company

Contractor

SECTION PLAT

		0	

330 Ft. from N. Line

..... Ft. from S. Line

..... Ft. from E. Line

330 Ft. from W. Line

FIRST REPORT

Location.....

Rig up.....

Drilling and Remarks:

Rig

RECORD

Cased..... in., ft.

Sand.....

Gas.....

Oil.....

Total Depth.....

PRODUCTION

1st 24 hrs. Nat.....

1st 24 hrs. after shot.....

Gas..... Cu. Ft.

Dry Hole.....

Abandoned.....

Date

APR 29 1936

192.....

LEWIS

Scout

Map No. 43 Sec. 25 Twp. 18 R. SW

Well No. 2 Cimarron

Continental Company

Contractor

SECTION PLAT

		○	

330 Ft. from N. Line

_____ Ft. from S. Line

_____ Ft. from E. Line

330 Ft. from W. Line

COMPLETED

Location _____

Rig up _____

Drilling and Remarks:

Sil 3130
4000 acid
Prod 1341 8 1/2

RECORD

Cased _____ in., _____ ft.

Sand _____

Gas _____

Oil _____

Total Depth 3169

PRODUCTION

1st 24 hrs. Nat. _____

1st 24 hrs. after shot _____

Gas _____ Cu. Ft.

Dry Hole _____

Abandoned _____

Date JUN 17 1936

S. J. LEWIS Scout