

KANSAS

Form 51-5M-7-40-Palace


Rice

Section 25 Township 18 Range 8-W

Well No. 5 Lansing "A"

Company Continental et al

NORTH Geneseo Pool

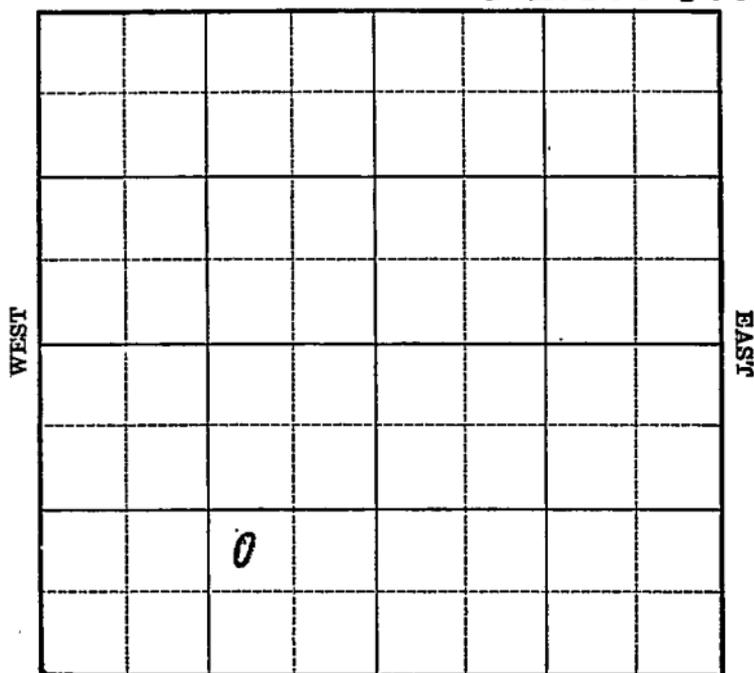

SOUTH

