

# KANSAS

Form 51-5M-7-40-Palace


Rice

Section 25 Township 18 Range 8-W

Well No. #6 Kimple

Company Continental et al

NORTH Geneseo Pool

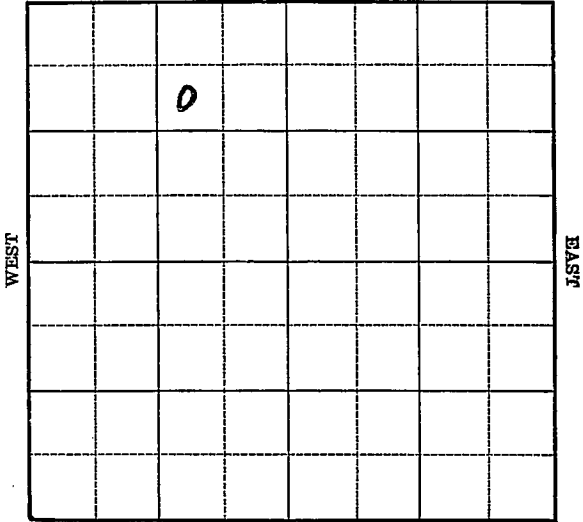

SOUTH





Map No. 45 Sec. 25 Twp. 18 R. 9WWell No. 6 KimpleContinental etal Company

Contractor

**COMPLETED**

SW NE NW

990 Ft. from N. Line       Ft. from S. Line990 Ft. from E. Line       Ft. from W. Line

GENESEO POOL

**SECTION PLAT**

	o		

Location \_\_\_\_\_

Rig up \_\_\_\_\_

Drilling and Remarks:

*CR 8.3155**6" @ 3156**Echrd Pt 5460**Max 3000**40' / 92***RECORD**

Cased \_\_\_\_\_ in., \_\_\_\_\_ ft.

Sand \_\_\_\_\_

Gas \_\_\_\_\_

Oil \_\_\_\_\_

Total Depth. 3218**PRODUCTION**

1st 24 hrs. Nat. \_\_\_\_\_

1st 24 hrs. after shot \_\_\_\_\_

Gas \_\_\_\_\_ Cu. Ft.

Dry Hole \_\_\_\_\_

Abandoned \_\_\_\_\_

Date

MAR 12 1941 19S. J. LEWIS Scout