

Rice

DX 78-1


KANSAS

Section 24 Township 18 Range 8W

Well No. #11 B.B. Ainsworth

Company Continental et al

NORTH

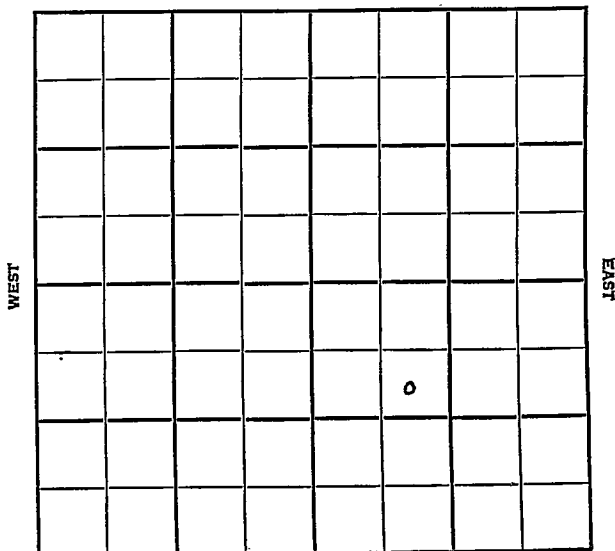

SOUTH

SEC.	TWP.	R.
24	18	8W

WELL NO. #11 B.B. Ainsworth FARM

COMPANY Continental et al

CONTRACTOR G-M-R


Geneseo Pool

_____ Ft. from N. Line

1675 _____ Ft. from S. Line

1650 _____ Ft. from E. Line

_____ Ft. from W. Line

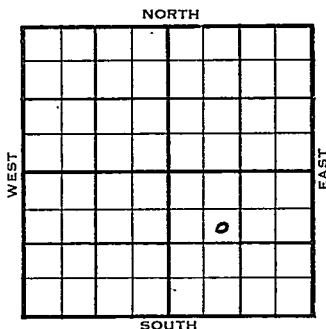

SE NW SE

1954	ELEVATION 1726'	REPORT
------	--------------------	--------

10/13 Spud 10-7-54
8" @ 309'

11/3 Drlg. 2656'
Spud 10-7-54
Oil Well
TD 3142'
8" @ 309'
Heeb 2622', Br. Lime 2744', Lans
2733', Arb 3137',
TD 3142'
5" @ 3139'
CO @ 3141'
FU 1200' oil 1 hr. S/ 84 bo 8 hr.
Comp 81 bopd.

COMPLETED

