

KANSAS


Rice

Form 51-5M-4-36-Palace

Section 25 Township 18 Range 8-W

Well Number 2-Kimple

Company Continental

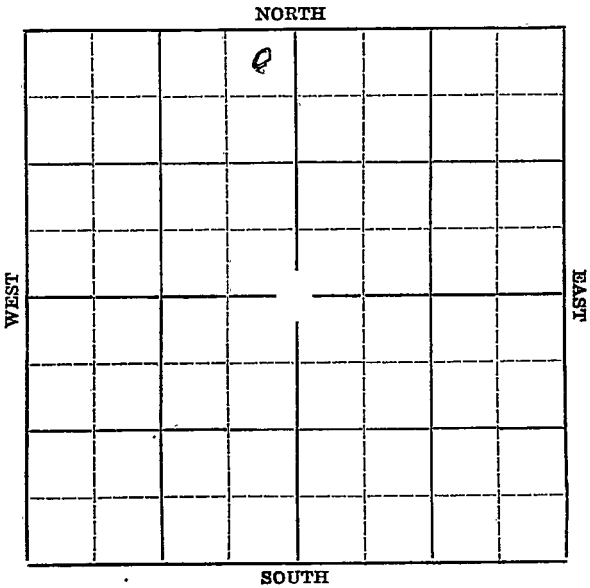

Map No. **KANSAS** Sec. 25 Twp. 18 R. 8W

Well No. #2 Kimple Farm

Continental. Company


330' Ft. from N. Line

_____ Ft. from S. Line

330' Ft. from E. Line

_____ Ft. from W. Line

Elev. 1721

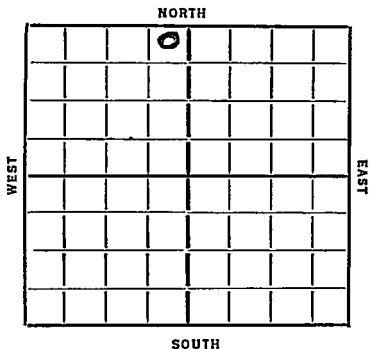

Date
1936

REPORT

- 5/13 Rig on ground.
- 5/21 Rigging up.
- 5/28 Drlg. 690'.
- 6/4 Drlg. 3005'.
- 6/11 Sil. 3133'. Set 7".
- 7/1/36-Sil. 3138'.
4000 gallons acid.
T.D. 3158'.
1796 bbls of oil. (Potential)

COMPLETED

Map No. 45 Sec. 25 Twp. 18 R. 8N

Well No. 2 Kimpfe

Continental Company

Contractor

SECTION PLAT

| | | | | |
|--|--|---|--|--|
| | | 2 | | |
| | | | | |
| | | | | |
| | | | | |

330 Ft. from N. Line

_____ Ft. from S. Line

330 Ft. from E. Line

_____ Ft. from W. Line

FILE NO. 037

Location _____

Rig up _____

Drilling and Remarks:

ROY

RECORD

Cased _____ in., _____ ft.

Sand _____

Gas _____

Oil _____

Total Depth _____

PRODUCTION

1st 24 hrs. Nat. _____

1st 24 hrs. after shot _____

Gas _____ Cu. Ft.

Dry Hole _____

Abandoned _____

Date

MAY 13 1936

E J LEWIS

Scout

Map No. 45 Sec. 25 Twp. 18 R. 8WWell No. 2 KnipfelerContinental Company

Contractor

SECTION PLAT

| | | | |
|--|---|--|--|
| | 0 | | |
| | | | |
| | | | |
| | | | |

350 Ft. from N. Line

_____ Ft. from S. Line

230 Ft. from E. Line

_____ Ft. from W. Line

COMPLETED

Location _____

Rig up _____

Drilling and Remarks:

Sil 31384000 acidP. 8. 1796

RECORD

Cased _____ in., _____ ft.

Sand _____

Gas _____

Oil _____

Total Depth 3158

PRODUCTION

1st 24 hrs. Nat. _____

1st 24 hrs. after shot _____

Gas _____ Cu. Ft.

Dry Hole _____

Abandoned _____

Date

JUL 1 1936 ₁₉

S. J. LEWIS Scout