


Rice

Form 51-5M-3-35-Mid-West

Map No. KANSAS Sec. 25 Twp. 18 R. 8W

Well No. #2-Lansing Farm
Continental Oil. Company

NORTH

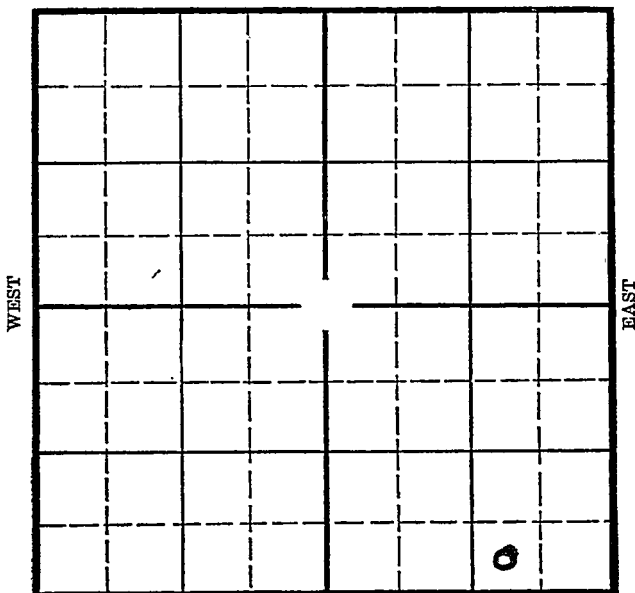

SOUTH

Location _____
 Drilling Remarks _____

Rig Up _____
 Drilling Remarks _____

RECORD

Cased _____ in. _____ ft.
 Sand _____
 Gas _____
 Oil _____
 Total Depth _____

PRODUCTION

1st 24 hrs. Nat. _____
 1st 24 hrs. after shot _____
 Gas _____ cu. ft. _____
 Dry Hole _____
 Abandoned _____

Well No. 2-Lansing Farm

Continental Oil Company

Ft. from N. Line

330 Ft. from S. Line

990 Ft. from E. Line

Ft. from W. Line

Elev. 1734

NORTH


SOUTH

REPORT

4/1	Location
-----	----------

4/10 Rig.

4/16 160' of 16". Drlg. 730'

4/23 Drlg. 2590'

4/30 Sil. 3168'-7" @ 3169'. T.D. 3170'.

Waiting on cement.

5/7 T.D. 3178'-2200' oil in 2½ hours.
H.F.O.

5/13/36- Sil. 3163'.

T.D. 3178'.

2000 acid.

1553 bbls.

COMPLETED

KANSAS

Map No. 45 Sec. 25 Twp. 18 R. 8W

Well No. 2-Lansing

Continental Oil Company

Contractor

FIRST REPORTS

SECTION PLAT

			0

Ft. from N. Line

330 Ft. from S. Line

990 Ft. from E. Line

Ft. from W. Line

Location ☒

Rig up

Drilling and Remarks:

RECORD

Cased _____ in., _____ ft.

Sand _____

Gas _____

Oil _____

Total Depth _____

PRODUCTION

1st 24 hrs. Nat. _____

1st 24 hrs. after shot _____

Gas _____ Cu. Ft.

Dry Hole _____

Abandoned _____

Date

ORVAL MANNSCHRECK

4-1-36 192

Scout

Map No. 43 Sec. 25 Twp. 18 R. 8W

Well No. 2 J. L. Lansing

Continental Company

Contractor

SECTION PLAT

_____ Ft. from N. Line

330 Ft. from S. Line

990 Ft. from E. Line

_____ Ft. from W. Line

COMPLETED

			0

Location _____

Rig up _____

Drilling and Remarks:

Oil 8/63

2000 acid

1553 8/64

RECORD

Cased _____ in., _____ ft.

Sand _____

Gas _____

Oil _____

Total Depth 3128

PRODUCTION

1st 24 hrs. Nat. _____

1st 24 hrs. after shot _____

Gas _____ Cu. Ft.

Dry Hole _____

Abandoned _____

Date

MAY 13 1936

19

S. J. LEWIS Scout