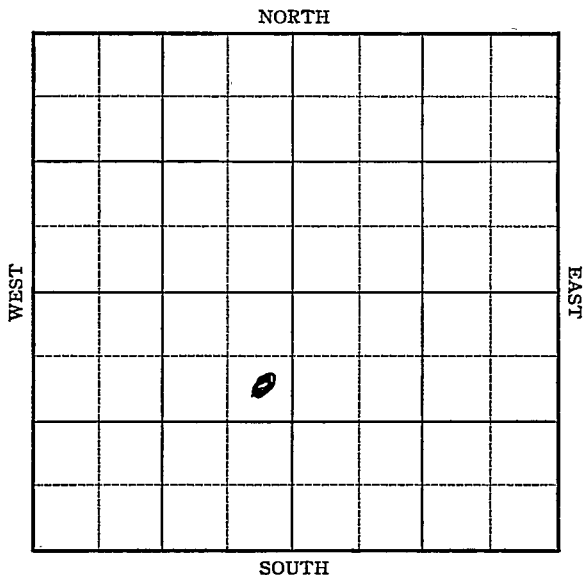


Section 25 Township 18 Range 8-WWell No. 2 - J. R. Lansing "A"Company Continental et al

Date	REPORT
1937	
6/16	B.R.R.
6/25	10" @ 86'. WOC.
7/2	Drlg. 2800'.
7/9	Sil. 3116'. 7" @ 3118'.
	T.D. 3123'. RUST.
7/16	T.D. 3145'. 1000' oil.
7/23	T.D. 3172'. 3100' oil.
7/28	7" @ 3118'.
	Sil.. 3116'.
	T.D. 3172'.
	4000 acid.
	Pot. 1497 bbls.
	COMPLETED

KANSAS

Map No. 45 Sec. 25 Twp. 18 R. 8 WWell No. 2-J. P. Lansing "A"Continental et al Company

Contractor

FIRST REPORT

SECTION PLAT

990 Ft. from N. Line Ft. from S. Line330 Ft. from E. Line Ft. from W. LineLocation Rig up

Drilling and Remarks:

B. R. R.

RECORD

Cased in., ft.Sand Gas Oil Total Depth

PRODUCTION

1st 24 hrs. Nat. 1st 24 hrs. after shot Gas Cu. Ft.Dry Hole Abandoned

Date

JUN 16 1937 19 H. D. Hatfield Scout

Rice KANSAS

Map No. _____ Sec. 25 Twp. 18 R. 8WWell No. 2-J. R. Lansing "A"Continental etal Company

Contractor _____

COMPLETED**SECTION PLAT**

990 Ft. from N. Line

_____ Ft. from S. Line

330 Ft. from E. Line

_____ Ft. from W. Line

Location _____

Rig up _____

Drilling and Remarks:

4000 AcidPot - 149.7**RECORD**Cased 7 in. 3118 ft.Sand 511 3116

Gas _____

Oil _____

Total Depth 3172**PRODUCTION**

1st 24 hrs. Nat. _____

1st 24 hrs. after shot _____

Gas _____ Cu. Ft.

Dry Hole _____

Abandoned _____

Date

JUL 28 1937 19E. D. Hatfield

Scout