
KANSAS
Form 51—5M—4-36—Palace

Rice.

Section 25 Township 18 Range 8W

Well Number #3 Kimple

Company Continental

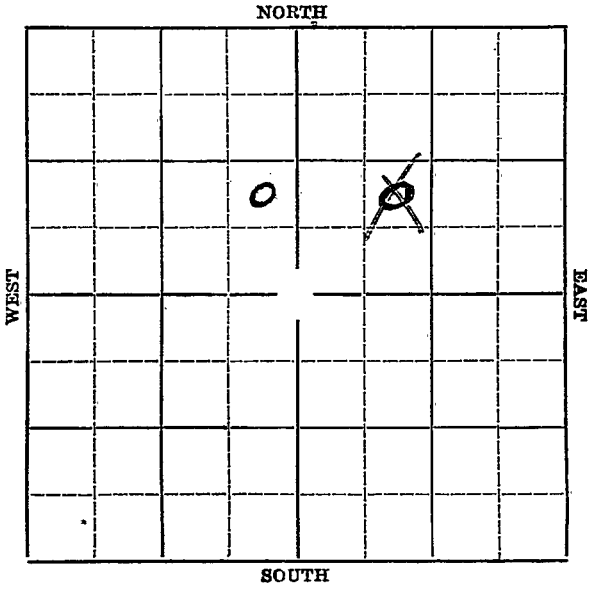


Form 252-A
5M 7-35 MPC

Rice

Map No. KANSAS Sec. 25 Twp. 18 R. 8W

Well No. #3 Kimple Farm

Continental Company

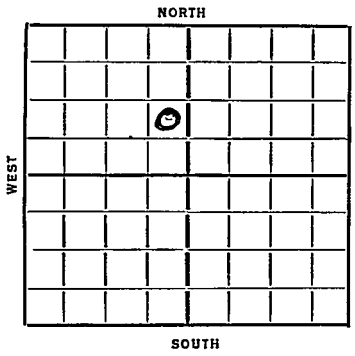

_____ Ft. from N. Line

990' Ft. from S. Line

330' Ft. from E. Line

_____ Ft. from W. Line

Date 1936	REPORT
5/27	Cellar
6/5	Rig.
6/11	200'. Waiting on cement.
6/18	Drlg. 2457'.
6/25	Sil. 3147'. Rigging up standard to
7/2	T.D. 3177'. 2900' oil. Acidizing.
7/9	4000 gallons of acid. 1058 bbls of oil potential.
7/15	36-Sil. 3147'.
	T.D. 3195'.
	4000 gallons of acid.
	1000 gallons of acid.
	1548 bbls of oil potential.
	COMPLETED

Form 26—1M Bks.—2-29

Rice

KANSAS


Map No. 45 Sec. 25 Twp. 18 R. 8 W

Well No. 3 Kimple

Continental Company

Contractor

SECTION PLAT

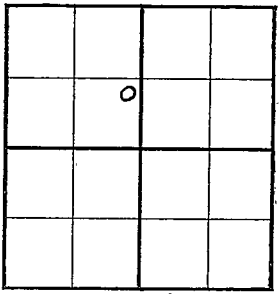

____ Ft. from N. Line

990 Ft. from S. Line

330 Ft. from E. Line

____ Ft. from W. Line

FIRST REPORT

Location ____

Rig up ____

Drilling and Remarks:

Oil Gas

RECORD

Cased ____ in., ____ ft.

Sand ____

Gas ____

Oil ____

Total Depth ____

PRODUCTION

1st 24 hrs. Nat. ____

1st 24 hrs. after shot ____

Gas ____ Cu. Ft.

Dry Hole ____

Abandoned ____

Date

MAY 1933

19

S. J. LEWIS Scout

Form 26—1M Bks.—2-29

KANSAS

Rice


Map No. 45 Sec. 25 Twp. 18 R. 8W

Well No. 3 Kinyon

Continental Company

Contractor

SECTION PLAT

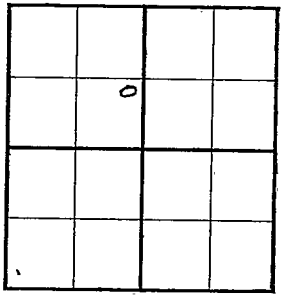

____ Ft. from N. Line

990 Ft. from S. Line

990 Ft. from E. Line

____ Ft. from W. Line

COMPLETED

Location

Rig up

Drilling and Remarks:

Si 63147

4000 acid

1000 acid

1548 P.D.

RECORD

Cased ____ in., ____ ft.

Sand

Gas

Oil

Total Depth 8195

PRODUCTION

1st 24 hrs. Nat.

1st 24 hrs. after shot

Gas ____ Cu. Ft.

Dry Hole

Abandoned

Date

JUL 15 1936 19

S. J. LEWIS Scout