


Section 25 Township 18 Range 8-W

Well No. #3 Lansing "A"

Company Continental

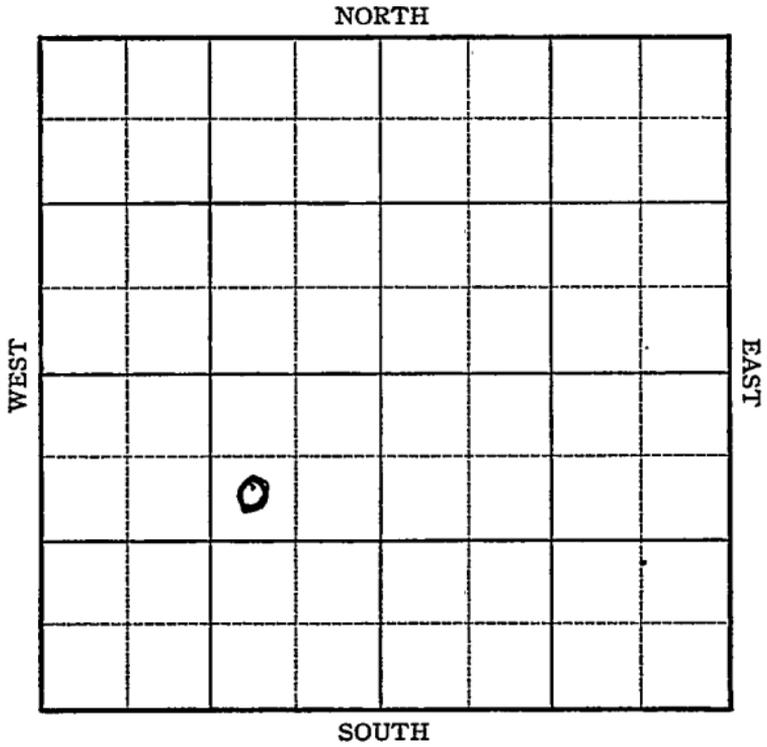

Sec. 25 Twp. 18 R. 8W

Well No. 3-Lansing "A" Farm

Continental Company


990 Ft. from N. Line

_____ Ft. from S. Line

990 Ft. from E. Line

_____ Ft. from W. Line

Elev. 1738

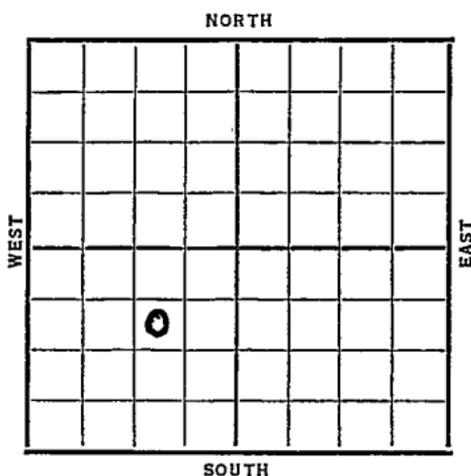

Date	REPORT
1937	
8/11	Location
8/20	Drlg. 1260'.
8/28	10" @ 175'. Drlg. 2965'.
9/3	Sil. & 7" @ 3137'.
	T.D. 3143'. No shows
	reported. RUST.
9/10	S.O. 3146-53'. Drlg. 3180'.
	1700' oil.
9/15	7" @ 3137'
	Sil 3137'
	TD 3226'
	3000 acid
	P - 320.86/4 & 310/4
	Pot 1861
	COMPLETED

Rice KANSAS

Map No. _____ Sec. 25 Twp. 18 R. 8^WWell No. 3-Lansing "A"Continental Company

Contractor _____

FIRST REPORT

SECTION PLAT

990 Ft. from N. Line

_____ Ft. from S. Line

990 Ft. from E. Line

_____ Ft. from W. Line

	0		

Location ✓

Rig up _____

Drilling and Remarks:

RECORD

Cased _____ in., _____ ft.

Sand _____

Gas _____

Oil _____

Total Depth _____

PRODUCTION

1st 24 hrs. Nat. _____

1st 24 hrs. after shot _____

Gas _____ Cu. Ft.

Dry Hole _____

Abandoned _____

Date

AUG 11 1937 19H. D. Hatfield Scout

Rice KANSAS

Map No. 45 Sec. 25 Twp. 18 R. 8 WWell No. 3-Lansing "A"Continental Company

Contractor

COMPLETED

SECTION PLAT

	0		

990 Ft. from N. Line

_____ Ft. from S. Line

990 Ft. from E. Line

_____ Ft. from W. Line

Location _____

Rig up _____

Drilling and Remarks:

3000 acidP-320.86/4 + 310/1/1Pat-1861

RECORD

Cased 7 in. 3137 ft.Sand sil 3137

Gas _____

Oil _____

Total Depth 3226

PRODUCTION

1st 24 hrs. Nat. _____

1st 24 hrs. after shot. _____

Gas _____ Cu. Ft.

Dry Hole _____

Abandoned _____

Date

SEP 15 1937 19

H. D. Hatfield Scout