


Section 25 Township 18 Range 8-W

Well Number #4 Ainsworth

Company Continental et al

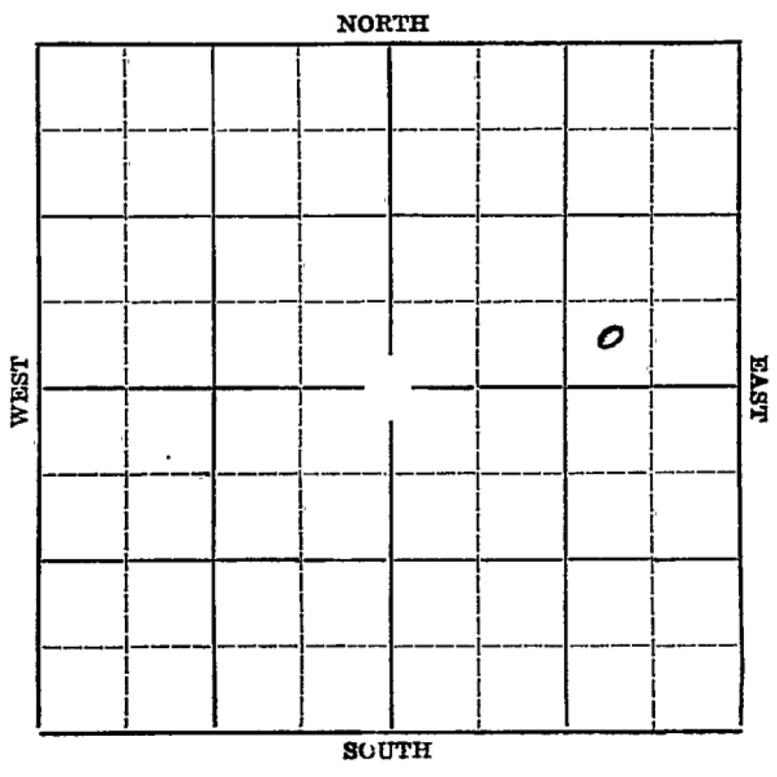

Map No. **KANSAS** Sec. **25** Twp. **18** R. **8W**

Well No. **#4 Ainsworth** Farm

Continental et al Company


_____ Ft. from N. Line

330' Ft. from S. Line

990' Ft. from E. Line

_____ Ft. from W. Line

Elev. 1715

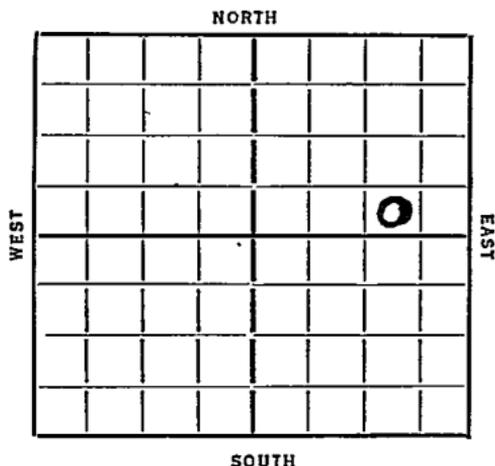

1936

REPORT

7/15 Cellar. Rig on ground.

7/23 Rigging up.

7/30 176'-12 $\frac{1}{2}$ ". Drlg. 2121'.

8/6 Siliceous 3135'. Drlg.

8/13 3137'. show of oil.

8/20 Sil. 3177'. 2900' of oil in hole.

8/26/36-Sil. 3135'.

T.D. 3181'.

2000 gallons of acid.

Potential 1103 bbls of oil in

20 hours.

COMPLETED

Map No. 45 Sec. 25 Twp. 18 R. SW

Well No. 4 Continental

Continental & Co. Company

Contractor

SECTION PLAT

			0

_____ Ft. from N. Line

330 Ft. from S. Line

990 Ft. from E. Line

_____ Ft. from W. Line

FIRST REPORT

Location _____

Rig up _____

Drilling and Remarks:

Ce Hat

R.D.G.

RECORD

Cased _____ in., _____ ft.

Sand _____

Gas _____

Oil _____

Total Depth _____

PRODUCTION

1st 24 hrs. Nat. _____

1st 24 hrs. after shot _____

Gas _____ Cu. Ft.

Dry Hole _____

Abandoned _____

Date

JUL 15 1936 19

S. J. LEWIS Scout

KANSAS

Map No. 45 Sec. 25 Twp. 18 R. 8W

Well No. 4 Ainsworth

Continental Company

Contractor

SECTION PLAT

			0

_____ Ft. from N. Line

230 Ft. from S. Line

990 Ft. from E. Line

_____ Ft. from W. Line

COMPLETED

Location _____

Rig up _____

Drilling and Remarks:

Bit 3135

2000 acid

P. J. 1103

20 hrs

RECORD

Cased _____ in., _____ ft.

Sand _____

Gas _____

Oil _____

Total Depth 3181

PRODUCTION

1st 24 hrs. Nat. _____

1st 24 hrs. after shot _____

Gas _____ Cu. Ft.

Dry Hole _____

Abandoned _____

Date

AUG 26 1936 19

S. J. LEWIS

Scout