


State \_\_\_\_\_ County Stafford  
 Company Harry Gore Well No. 1  
 Farm Pondack  
 Survey \_\_\_\_\_

Block No. \_\_\_\_\_ Sec. 19 Twp. 21 Range 13w  
 Co-Ord. Se 1/4 19 Elev. 1921

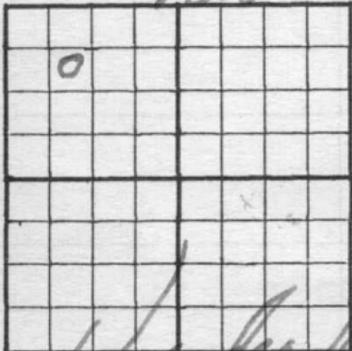

3649  
 1921  
 -1728

3369  
 1921  
 -1447

Seiberly Co.

NOTE: Show Sketch of Lease and Well Location in Above Space

Ft. from N. Line \_\_\_\_\_ Ft. from S. Line \_\_\_\_\_  
 Ft. from W. Line \_\_\_\_\_ Ft. from E. Line \_\_\_\_\_

Date	Depth	
		858" - 226
	3237	Heeb
	3368	Lans. -1447
	D St	3526-40 open
	1/2 hr	rec 30' mud
	BHP	1290 #
	D St	3549-79 open
	45"	rec 8' mud
	3649	Simpson

