
KANSAS
Form 51—5M—4-36—Palace

Rice

Section 25 Township 18 Range 8W

Well Number #4 J. Lansing

Company Continental

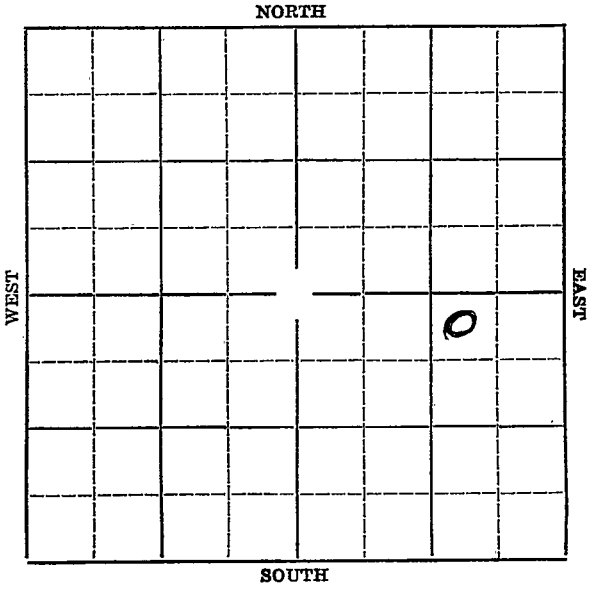

Form 252-A
5M 7-35 MPC

RICE

Map No. KANSAS Sec. 25 Twp. 18 R. 8W

Well No. #4 J. Lansing Farm


Continental. Company

330' Ft. from N. Line

Ft. from S. Line

990' Ft. from E. Line

Ft. from W. Line

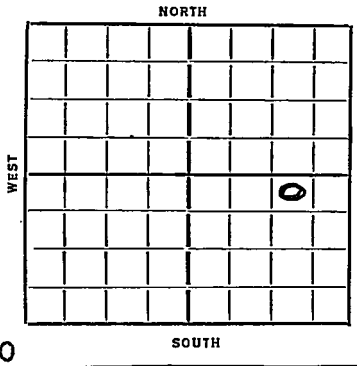

Elev. 1700

Date 1936	REPORT
5/20	Cellar.
5/28	Rig.
6/4	166' Waiting on cement.
6/11	Drlg. 2415'.
7/8/36	Sil. 3107'.
	4000 gallons of acid.
	T.D. 3148'.
	755 bbls of oil.
	COMPLETED

Form 26—1M Bks.—2-29

Rice

KANSAS


Map No. 45 Sec. 25 Twp. 18 R. 8 W

Well No. 4 J. Lansing

Continental Company

Contractor

SECTION PLAT

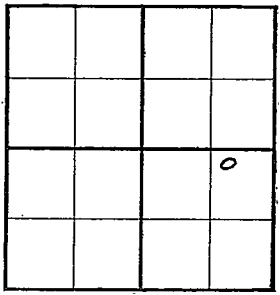

830 Ft. from N. Line

Ft. from S. Line

990 Ft. from E. Line

Ft. from W. Line

FIRST REPORT

Location

Rig up

Drilling and Remarks:

Cellar

RECORD

Cased in., ft.

Sand

Gas

Oil

Total Depth

PRODUCTION

1st 24 hrs. Nat.

1st 24 hrs. after shot

Gas Cu. Ft.

Dry Hole

Abandoned

Date

MAY 20 1936

19

S. J. LEWIS

Scout

Form 26—1M Bks.—2-29

KANSAS


Map No. 45 Sec. 25 Twp. 18 R. 8 W

Well No. 4 Lansing "B"

Continental Company

Contractor

SECTION PLAT

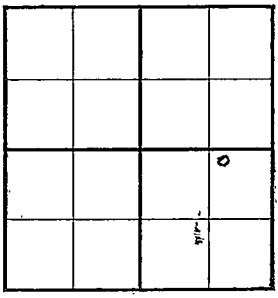

330 Ft. from N. Line

____ Ft. from S. Line

990 Ft. from E. Line

____ Ft. from W. Line

COMPLETED

Location

Rig up

Drilling and Remarks:

8-6-36

4000 acid

7554 lb.

RECORD

Cased ____ in., ____ ft.

Sand

Gas

Oil

Total Depth 3148

PRODUCTION

1st 24 hrs. Nat.

1st 24 hrs. after shot

Gas ____ Cu. Ft.

Dry Hole

Abandoned

Date

JUL 8 1936

19

S. J. LEWIS

Scout