


Section 25 Township 18 Range 8-W

Well Number #5 S. Ainsworth

Company Continental

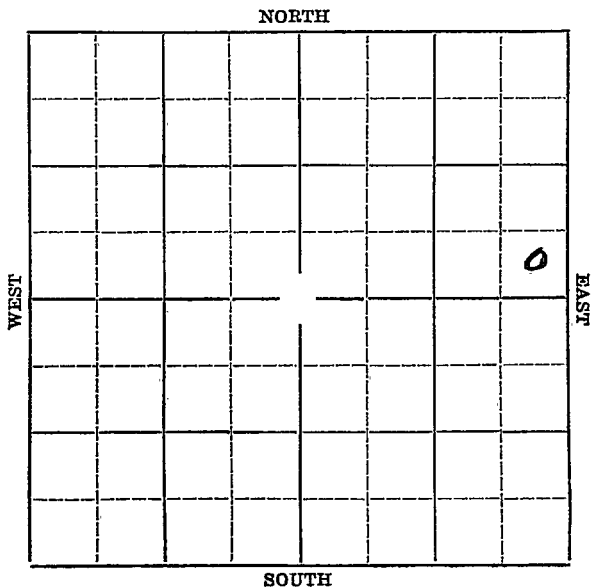

KANSAS

Map No. 45 Sec. 25 Twp. 18 R. 8W

Well No. 5 S. Dinsmore

Continental Company

Contractor

SECTION PLAT

			o

_____ Ft. from N. Line

320 Ft. from S. Line

330 Ft. from E. Line

_____ Ft. from W. Line

FIRST REPORT

Location ✓

Rig up _____

Drilling and Remarks:

RECORD

Cased _____ in., _____ ft.

Sand _____

Gas _____

Oil _____

Total Depth _____

PRODUCTION

1st 24 hrs. Nat. _____

1st 24 hrs. after shot _____

Gas _____ Cu. Ft.

Dry Hole _____

Abandoned _____

Date

OCT 14 1936

19

S. J. LEWIS Scout

KANSAS

Map No. 45 Sec. 25 Twp. 18 R. 8W.

Well No. 5 S. Amisworth

Continental Company

Contractor

SECTION PLAT

			o

_____ Ft. from N. Line

330 Ft. from S. Line

330 Ft. from E. Line

_____ Ft. from W. Line

COMPLETED

Location _____

Rig up _____

Drilling and Remarks:

Oil 3113
2000 acil
P 8947

RECORD

Cased _____ in., _____ ft.

Sand _____

Gas _____

Oil _____

Total Depth 3150

PRODUCTION

1st 24 hrs. Nat. _____

1st 24 hrs. after shot _____

Gas _____ Cu. Ft.

Dry Hole _____

Abandoned _____

Date

DEC 16 1936₁₉

S. J. LEWIS

Scout