

Map No. K14 Sec. 31 Twp. 25 R. 5

Well No. 80 Murphy
Empire Company

Contractor

SECTION PLAT

----- Ft. from N. Line

990 Ft. from S. Line

----- Ft. from E. Line

990 Ft. from W. Line

0			

FIRST REPORT

Location -----

Rig up -----

Drilling and Remarks:

RECORD

Cased ----- in., ----- ft.

Sand -----

Gas -----

Oil -----

Total Depth -----

PRODUCTION

1st 24 hrs. Nat. -----

1st 24 hrs. after shot -----

Gas ----- Cu. Ft.

Dry Hole -----

Abandoned -----

Date

5/17 191

Pyle Scout


L1003

Map No. K14 Sec. 31 Twp. 25 R. 5

Well No. '80 Murphy Farm

Empire Company.

NORTH

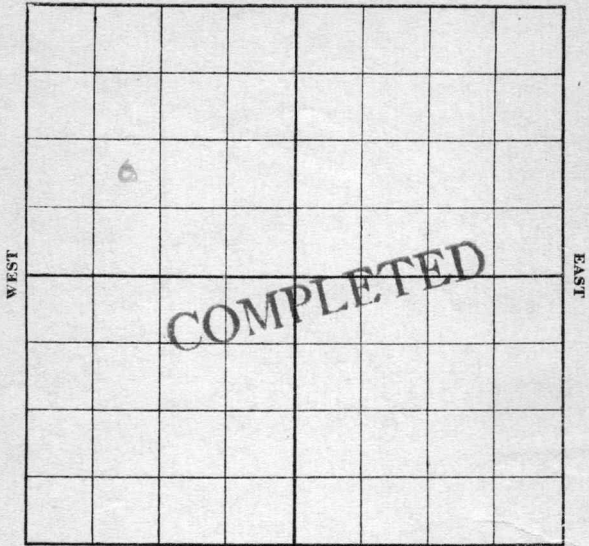

990 S-W SOUTH

Location

Rig up

Drilling and Remarks:

RECORD

Cased in., ft.

Sand 2484-91

Gas

Oil

Total Depth

PRODUCTION

1st 24 hrs. Nat. 8 bbls

1st 24 hrs. after shot

Gas Cu. Ft.

Dry Hole

Abandoned

Date

Pyle

8/21 1920 Scout.