


Map No. 11 Sec. 1 Twp. 29 R. 5

Well No. 5 Hayward

Farm Hayward

Company Jay Rankin

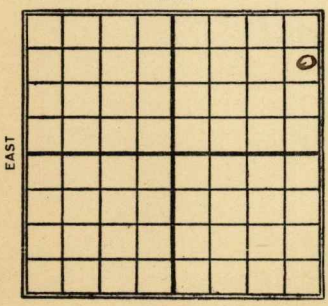

Ft. from N. Line _____

810 Ft. from S. Line _____

Ft. from E. Line _____

700 Ft. from W. Line _____

Date 1/13

REPORT

COMPLETED


2816-6 2530 719
 2816-6 2530 719
 135-138
 Shot 4098 - Downy
 135-138

Map No. 11 Sec. 1 Twp. 29 R. 5

Well No. 5 Haggart Farm
Jay Hawbert Company

Date Started _____ Ft. from N. S 8/0 E. W 200 line

NORTH Kansas

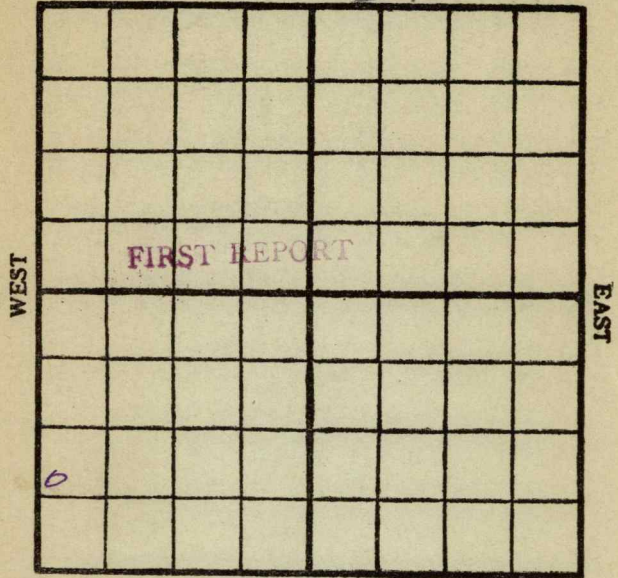

SOUTH

Cased _____ In. _____ Ft.	Production Remarks	
Sand _____		
Pay {		Gas _____
		Oil _____
Total Depth _____		

Condition of Well on this date _____

20-1000'

M. A. BENEAR

Scout

K11 *Kans*
 Map No. *1* Sec. *29* Twp. *5*
 Well No. *3* *Haggart*
Jay Hawker Company
 Contractor

COMPLETED

SECTION PLAT

----- Ft. from N. Line
810 Ft. from S. Line
 ----- Ft. from E. Line
200 Ft. from W. Line

Location -----

RECORD

Cased ----- in., ----- ft.
 Sand -----
 Gas -----
 Oil -----
 Total Depth -----

PRODUCTION

1st 24 hrs. Nat. -----
 1st 24 hrs. after shot -----
 Gas ----- Cu. Ft.
 Dry Hole -----
 Abandoned -----

Drilling and Remarks:
Top sand 2716' to
2730 T.D.
shot
40 gts.
flowing 135' H.S.

Date

FEB 4 1922

M. A. BENEAR