

KANSAS

Rice


Form 51-5M-7-40-Palace

Section 25 Township 18 Range 8-W

Well No. 6 Lansing "A"

Company Continental et al

NORTH Geneseo Pool

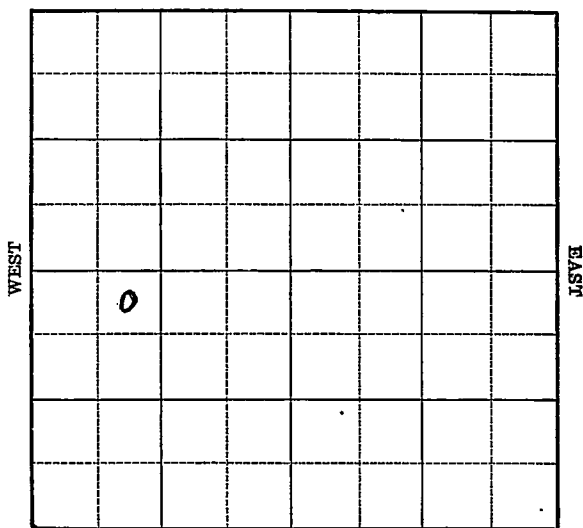

SOUTH

Sec. 25 Twp. 18 R. 8-W

Well No. #6 Lansing "A" Farm

Continental et al Company

(Genesee)


330 Ft. from N. Line

_____ Ft. from S. Line

_____ Ft. from E. Line

990 Ft. from W. Line

Elev. 1749

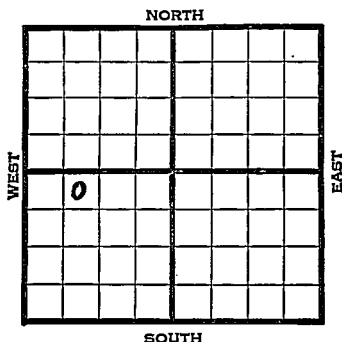

1941	REPORT
2/19	9" - 200' WOC.
2/27	Drillg. 2633'
3/6	Arb. 3169-85' T.D. 6" - 3170' RUST.
3/13	T.D. 3229' Swab 115 bbls. oil 3 hours. 5000 acid.
3/19	Arb. 3169'
	6" - 3170'
	T.D. 3229'
	5000 acid.
	Echometer potential 1988 bbls.
	40.1 Gravity
	COMPLETED

Map No. 45 Sec. 25 Twp. 18 R. 8WWell No. 6 Lansing "A"Continental etal Company

Contractor

FIRST REPORT

SECTION PLAT

NE NW SW

330 Ft. from N. Line

_____ Ft. from S. Line

_____ Ft. from E. Line

990 Ft. from W. Line

GENESEO POOL

Location _____

Rig up _____

Drilling and Remarks:

9" - 200

WOC

RECORD

Cased _____ in., _____ ft.

Sand _____

Gas _____

Oil _____

Total Depth _____

PRODUCTION

1st 24 hrs. Nat. _____

1st 24 hrs. after shot _____

Gas _____ Cu. Ft.

Dry Hole _____

Abandoned _____

Date

FEB 19 1941

19

S. J. LEWIS

Scout

Map No. 45 Sec. 25 Twp. 18 R. 8W

Well No. 6 Lansing "A"

Continental etal Company

Contractor

COMPLETED

SECTION PLAT

NE NW SW

330 Ft. from N. Line

_____ Ft. from S. Line

_____ Ft. from E. Line

990 Ft. from W. Line

GENESEO POOL

Location _____

RECORD

Rig up _____

Cased _____ in., _____ ft.

Drilling and Remarks:

Sand _____

Cr + 2169

Gas _____

6" @ 3170

Oil _____

5000.0000

Total Depth 3229

Ech + 1988

PRODUCTION

1st 24 hrs. Nat. _____

1st 24 hrs. after shot _____

40 1/2 Gr.

Gas _____ Cu. Ft.

Dry Hole _____

Abandoned _____

Date

MAR 19 1941 19

S. J. LEWIS Scout