


Map No. 01115 **KANSAS** Sec. 5 Twp. 12 R. 17^w
Well No. 1-Clinton Farm Phillips Company Pet

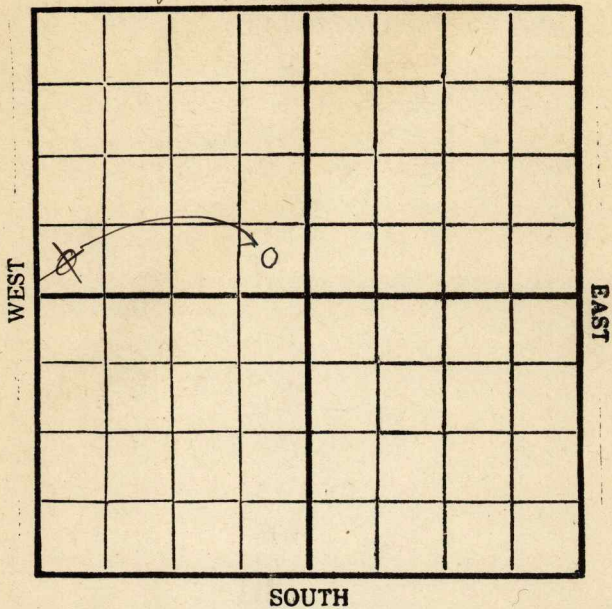

Location _____
Drilling Remarks _____

RECORD

Cased _____ in. _____ ft.
Sand _____
Gas _____
Oil _____
Total Depth _____

Rig Up _____
Drilling Remarks _____

PRODUCTION


1st 24 hrs. Nat. _____
1st 24 hrs. after shot _____
Gas _____ cu. ft. _____
Dry Hole _____
Abandoned _____

Map No. **KANSAS** Sec. 5 Twp. 12 R. 17^w

Well No. 1-Clinton Farm

Phillips Pet Company

NORTH

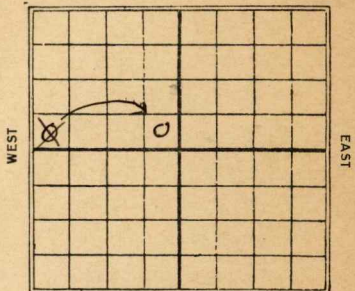

 Ft. from N. Line

330 Ft. from S. Line

330 Ft. from E. Line

330 Ft. from W. Line

1930

Date

REPORT

2/5	Bldy Rig
2/12	
2/19	Spud 225.
2/26	" 325
3/5	Drlg. 1215.
3/12	" 1800'
3/19	" 2575'
3/26	2 1/2" 10" - 2810'
4/2	Drlg. 2900'
4/9	S. 10" 2930'
4/16	Drlg. 2990'
4/23	" 3145'
4/30	" 3438' show oil 3355'
5/7	show oil 3528-87' T.P. 3620 - U.P. 8"
5/14	Slg. out 3620'
5/21	Sand 3641-47 TD 3647 swab 165 bbl oil Comp.

Map No. **KANSAS** Sec. 5 Twp. 12 R. 12W

Well No. 1 Clinton

Phillips Pe & J. Company

Contractor

SECTION PLAT

.....Ft. from N. Line

280 Ft. from S. Line

.....Ft. from E. Line

280 Ft. from W. Line

FIRST REPORTS

Location.....

Rig up.....

Drilling and Remarks:

Building rig

RECORD

Cased..... in., ft.

Sand.....

Gas.....

Oil.....

Total Depth.....

PRODUCTION

1st 24 hrs. Nat.....

1st 24 hrs. after shot.....

Gas..... Cu. Ft.

Dry Hole.....

Abandoned.....

Date

FEB 5 1930

S. J. LEWIS

192

Scout


Map No. **KANSAS** Sec. 5 Twp. 12 R. 12 W

Well No. 71 Clinton

Phillips P. & S. Company

Contractor

SECTION PLAT

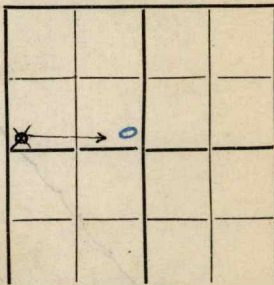

.....Ft. from N. Line

230 Ft. from S. Line

230 Ft. from E. Line

.....Ft. from W. Line

CORRECTION

Location.....

Rig up.....

Drilling and Remarks:

Reperated 8/1/10

RECORD

Cased.....in.,ft.

Sand.....

Gas.....

Oil.....

Total Depth.....

PRODUCTION

1st 24 hrs. Nat.....

1st 24 hrs. after shot.....

Gas.....Cu. Ft.

Dry Hole.....

Abandoned.....

Date

MAY 14 1930

192.....

S. J. LEWIS

Scout

Map No. **KANSAS** Sec. 5 Twp. 12 R. 17W
 Well No. 71 Clinton

Phillips P. & S. Company
 Contractor

SECTION PLAT

	0		

.....Ft. from N. Line
330 Ft. from S. Line
330 Ft. from E. Line
Ft. from W. Line

COMPLETED

Location.....

Rig up.....

Drilling and Remarks:

swab.
16588 1/2

RECORD

Cased.....in.,ft.
 Sand 3641-47
 Gas.....
 Oil.....
 Total Depth 3647

PRODUCTION

1st 24 hrs. Nat.....
 1st 24 hrs. after shot.....
 Gas.....Cu. Ft.
 Dry Hole.....
 Abandoned.....

Date

MAY 21 1930 192..... **S. J. LEWIS** Scout