KANSAS


Rice

Form 51—5M—7-40—Palace

Section 25 Township 18 Range 8-W

Well No. 7 Ainsworth

Company Continental e t al

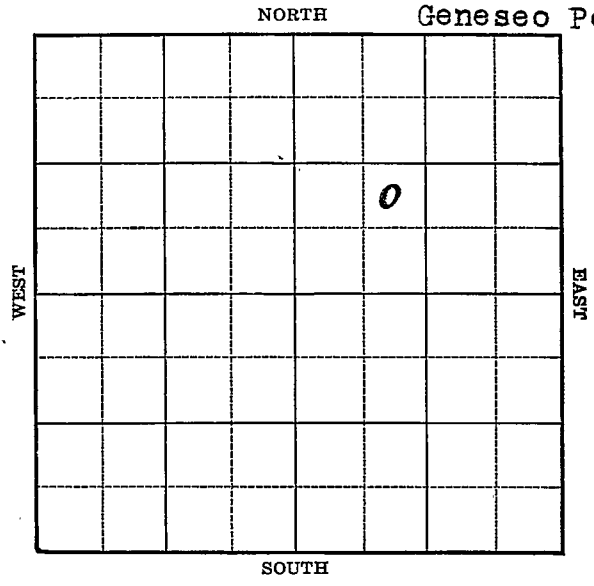

FORM 252-A 5M 2-40 KANSAS . Rice

Sec. 25 Twp. 18 R. 8-W

Well No. #7 Ainsworth Farm

Continental et al Company

(Geneseo)


____ Ft. from N. Line

990 Ft. from S. Line

____ Ft. from E. Line

990 Ft. from W. Line

Elev. 1733

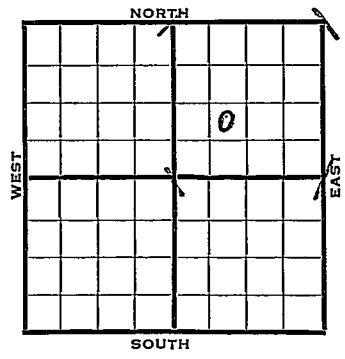

1941	REPORT
1/29	Derrick.
2/6	220' run 9".
2/13	9" - 205' Drlg. 2530'
2/20	Arb. 3143-59' T.D. 6" - 3144'
	RUST.
2/27	T.D. 3213' Swab 454 oil 5 hrs.
3/5	Arb. 3143'
	6" - 3144'
	T.D. 3213'
	Echometer potential 10,421 bbls.
	Maximum 3000 bbls.
	40.1 Gravity
	COMPLETED

Form 26—200 Bks.—1-40—Palace Rice KANSAS

Map No. 45 Sec. 25 Twp. 18 R. 8W

Well No. 7 Ainsworth

Continental etal Company

FIRST REPORT Contractor

NE SW NE

_____ Ft. from N. Line


990 Ft. from S. Line

_____ Ft. from E. Line

990 Ft. from W. Line

GENESEO POOL

SECTION PLAT

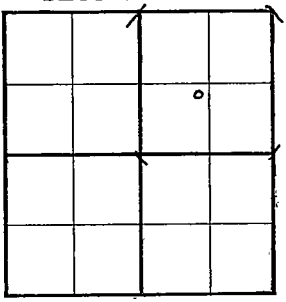

Location _____

Rig up _____

Drilling and Remarks:
Derrick

RECORD

Cased _____ in., _____ ft.

Sand _____

Gas _____

Oil _____

Total Depth _____

PRODUCTION

1st 24 hrs.-Nat. _____

1st 24 hrs. after shot _____

Gas _____ Cu. Ft.

Dry Hole _____

Abandoned _____

Date

JAN 29 1941 19

S. J. LEWIS Scout

Form 26—200 Bks.—1-40—Palace Rice KANSAS

Map No. 45 Sec. 25 Twp. 18 R. 8W

Well No. 7 Ainsworth

Continental etal Company

COMPLETED Contractor

NE SW NE

____ Ft. from N. Line


990 Ft. from S. Line

____ Ft. from E. Line

990 Ft. from W. Line

GENESEO POOL

SECTION PLAT

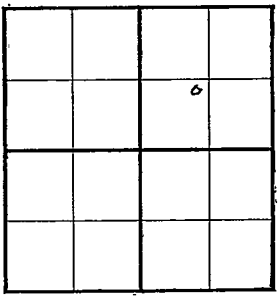

Location ____

Rig up ____

Drilling and Remarks:

Gr 3143

6" @ 3144

Echo P.B. 10421

May 3000

40 - Gr.

RECORD

Cased ____ in., ____ ft.

Sand ____

Gas ____

Oil ____

Total Depth 3213

PRODUCTION

1st 24 hrs. Nat. ____

1st 24 hrs. after shot ____

Gas ____ Cu. Ft.

Dry Hole ____

Abandoned ____

Date

MAR 5 1941 19 S. J. LEWIS Scout