


KANSAS

Section 5 Township 12 Range 17-W

Well Number 2 Bertha

Company Phillips et al

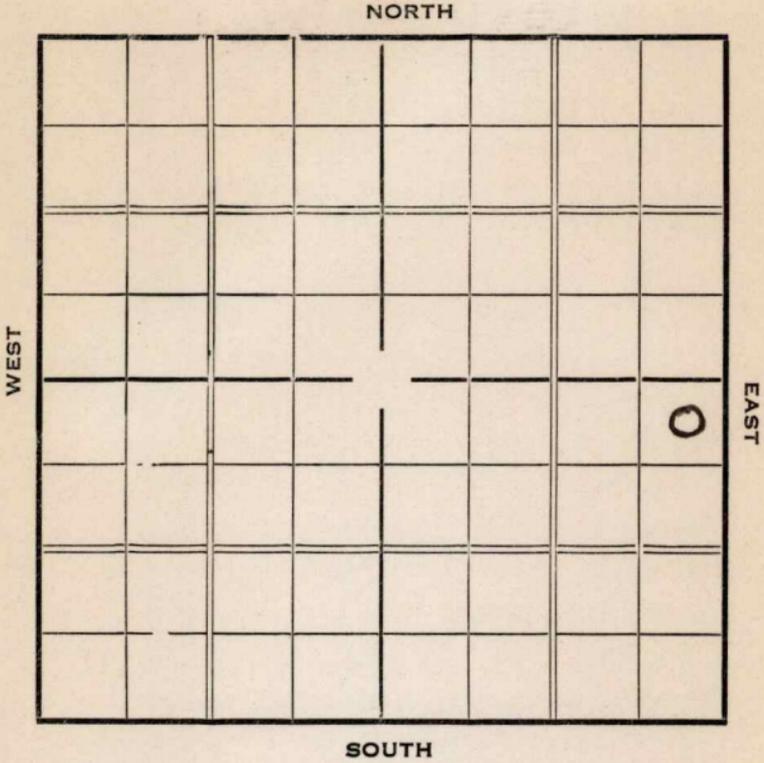

Sec. 5 Twp. 12 R. 17-W

Well No. #2 Bertha Farm

Phillips et al Company


330 Ft. from N. Line

_____ Ft. from S. Line

330 Ft. from E. Line

_____ Ft. from W. Line

Elev. 2035

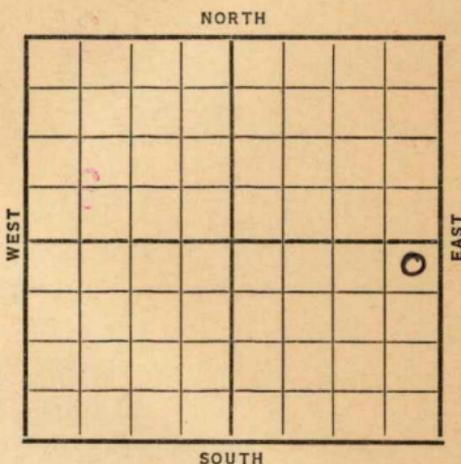

Date

REPORT

1937

3/24 R O G

4/2 Rig

4/8 "

4/16 Drlg. 1090(

4/23 10" @ 1081'.

Anhydrate 1250'. Drlg. 1870

4/30 Top K. C. 3245'.

Coring @ 3286'.

5/7 Sil. 3508'. 7" @ 3508'.

T.D. 3509'. O.O.

5/12 7" @ 3508'.

Sil. 3508'.

T.D. 3520'.

2000 acid.

Pot. 2416 bbls. 24 hrs.

COMPLETED

KANSAS *Ellis*

Map No. 471 Sec. 5 Twp. 12 R. 17W.

Well No. 2. Bertha

Phillips & Co Company

Contractor

SECTION PLAT

330 Ft. from N. Line

_____ Ft. from S. Line

330 Ft. from E. Line

_____ Ft. from W. Line

			6

FIRST REPORT

Location _____

Rig up _____

Drilling and Remarks:

R.O.G.

RECORD

Cased _____ in., _____ ft.

Sand _____

Gas _____

Oil _____

Total Depth _____

PRODUCTION

1st 24 hrs. Nat. _____

1st 24 hrs. after shot _____

Gas _____ Cu. Ft.

Dry Hole _____

Abandoned _____

Date

MAR 24 1937 19

S. J. LEWIS Scout

Map No. 71 Sec. 5 Twp. 12 R. 17^W

Well No. 2-Bertha
Phillips etal Company

Contractor

COMPLETED

SECTION PLAT

330 Ft. from N. Line

_____ Ft. from S. Line

330 Ft. from E. Line

_____ Ft. from W. Line

			0

Location _____

Rig up _____

Drilling and Remarks:

2000 Acid

POT - 2416 / 24 hrs

RECORD

Cased 7 in., 3508 ft.

Sand 511 - 3508

Gas _____

Oil _____

Total Depth 3520

PRODUCTION

1st 24 hrs. Nat. _____

1st 24 hrs. after shot _____

Gas _____ Cu. Ft.

Dry Hole _____

Abandoned _____

Date

MAY 12 1937 19

H. D. Hatfield

Scout