

KANSAS

Rice


FORM 51 5M 2-38 TPCO.

O.W.W.O.

Section 25 Township 18 Range 8-W

Well No. 7 Lansing "B"

Company Continental

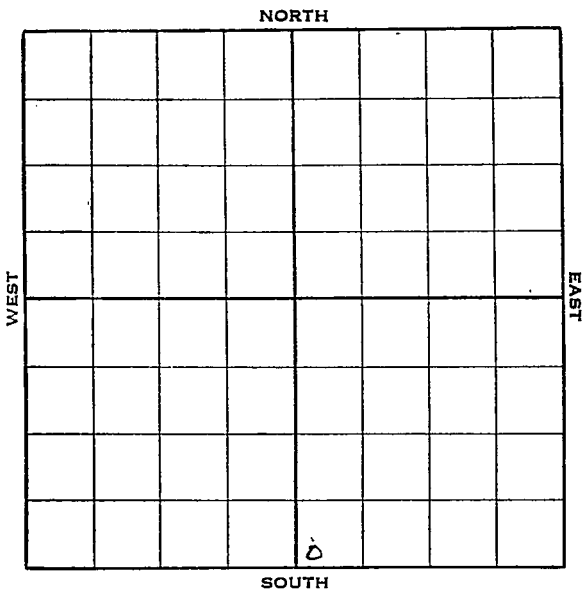

KANSAS

Rice O.W.W.O.

Sec. 25 Twp. 18 R. 8-WWell No. #7 Lansing "B" Farm  
Continental Company


\_\_\_\_\_ Ft. from N. Line

330 Ft. from S. Line

\_\_\_\_\_ Ft. from E. Line

330 Ft. from W. Line

Elev. 1718'

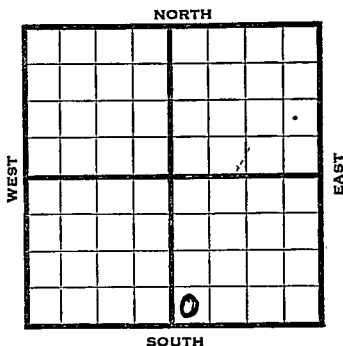

1938	REPORT
6/15	B.R.R.
6/24	10" - 205'. Drlg. 595'.
7/1	Arb. 3130' - 31' T.D. Rng. 7"
7/8	7" - 3130'. Drlg. 3153'.
	300' oil.
7/15	T. D. 3208'. 3000' oil.
7/22	2000 acid. Pump 365 oil & 181 water in 7 hrs. Will P. B.
7/29	P. B. 3178'. Swab 803 oil & 17 wtr. in 10½ hrs.
8/3	7" at 3130'.
	Arb. 3130'.
	T. D. 3208'.
	2000 acid.
	Pump 365 oil & 181 water in 7 hrs.
	P. B. to 3178'.
	Pump 368 bbls. 4 hrs. & 311 bbls. 4 hrs.
	Potential 1866 bbls. No water.
	<b>COMPLETED OVER</b>

1955

W.O.

4/27

Oil Well  
TD 3178'  
KC 2757', Simp 3097', Arb. 3128'  
OTD 3178'  
7" @ 3130'  
PB 3106'  
CO to 3125'  
36/ 3110-22 frac. re-frac. re-frac.  
PB 3018'  
24/ 2970'-74 24/ 2958'-64'  
B/ 15 gw 5 go 10 hr. 250 A.  
S/ 9 bo 6 hr. SP 2882'  
42/ 2854-68 B/ 1 $\frac{1}{2}$  bo 12 bw. 6  
hr.  
SP 2843  
23/ 2776-84 B/ 4 go 4 hr.  
500 A S/ 9 bo 6 hr. 2000 A  
P/ 20 bo 13 baw 24 hr. P/ 8 bp  
6 hr.  
Comp 10 bopd.

FIRST REPORT

COMPLETED

Rice

KANSAS

Map No. 45 Sec. 25 Twp. 18 R. 8WWell No. 7 LansingContinental

Company

Contractor

## FIRST REPORT

## SECTION PLAT

SW SE

\_\_\_\_\_ Ft. from N. Line

330 Ft. from S. Line

\_\_\_\_\_ Ft. from E. Line

330 Ft. from W. Line

		0	

Location \_\_\_\_\_

Rig up \_\_\_\_\_

Drilling and Remarks:

BRR

## RECORD

Cased \_\_\_\_\_ in., \_\_\_\_\_ ft.

Sand \_\_\_\_\_

Gas \_\_\_\_\_

Oil \_\_\_\_\_

Total Depth \_\_\_\_\_

## PRODUCTION

1st 24 hrs. Nat. \_\_\_\_\_

1st 24 hrs. after shot \_\_\_\_\_

Gas \_\_\_\_\_ Cu. Ft.

Dry Hole \_\_\_\_\_

Abandoned \_\_\_\_\_

Date

JUN 15 1938

19

H. D. Hatfield Scout

Map No. 45 Sec. 25 Twp. 18 R. 8WWell No. 7 LansingContinental Company

Contractor

**COMPLETED**

SW SE

## SECTION PLAT

		0	

       Ft. from N. Line330 Ft. from S. Line       Ft. from E. Line330 Ft. from W. LineLocation       Rig up       

Drilling and Remarks:

2000 Acid  
 Pump 365 oil &  
 181 wtr in 7 hrs  
 P.B. 3178  
 P. 368/4 & 311/4  
 POT 1866 No wtr

## RECORD

Cased 7 in., 3130 ft.Sand Arb 3130Gas       Oil       Total Depth 3208

## PRODUCTION

1st 24 hrs. Nat.       1st 24 hrs. after shot       Gas        Cu. Ft.Dry Hole       Abandoned       

Date

AUG 3 - 1938 19

H. D. Hatfield Scout

O.W.W.O.

County Rice State Kansas

Sec. 25 (Blk. 18) (Sur. Rge.) SW Map No.

Operator Continental Oil

Well No. 7 Farm J. R. Lansing "B"

Elev. 1718 Location SW SW SE

FIRST REPORT				
COMPLETE				

330 Ft. From S Line SE

330 Ft. From W Line Quarter

1st. Report APR 27 1955

Completion APR 27 1955

Remarks OTWO

Spudding Date

Drlg. Data Oil well TD 3178

KC 2757 Simp. 3097 Arb. 3128 OTD 3178

7" @ 3130 PB 3106 CO to 3125 36/ 3110-

22 frac re-frac refrac PB 3018

24/ 2970-74 24/ 2958-64 B/ 15 gw 5 go

10 hr. 250 A S/ 9 bo 6 hr. SP 2882

42/ 2854-68 B/ 1 1/2 bo 12 bw 6 hr.

SP 2843 23/ 2776-84 B/ 4 go 4 hr.

500 A S/ 9 bo 6 hr. 2000 A P/ 20 bo

13 baw 24 hr. P/ 8 bp 6 hr.

Comp. 10 bopd.

FABEN GILSTRAP