


State Kansas County Ellis
 Company Messmer-Renick Co. Well No. 1
 Farm Jay (washdown)
Republ. oil bus #1 Jay "B"
 Survey _____
 Block No. _____ Sec. 14 Twp. 12^s Range 18^w
 Co-Ord. _____ Elev. 2132 0/F

O. Ke Ke Ke

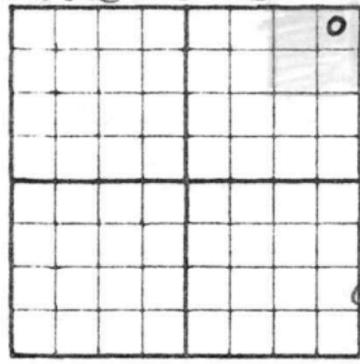

100% - Erie Dev. Co.

Cont. - Red Tiger Delg.
(Sully)

NOTE: Show Sketch of Lease and Well Location in Above Space

330 Ft. from N. Line Ft. from S. Line

Ft. from W. Line 330 Ft. from E. Line

Date	Depth	
<u>8/11</u>		<u>M.S.L.G.</u>
<u>8/12</u>		<u>Hit first plug</u> <u>@ 10:00 a.m. - 3800' harden</u> <u>second plug @ 225'</u>
	<u>231</u>	<u>C.O. Depth</u>
<u>8/13</u>	<u>2437</u>	<u>Delg.</u>
<u>8/14</u>	<u>2867</u>	<u>Delg. Cir.</u>
<u>8/15</u>	<u>3326</u>	<u>Trip</u>
<u>8/16</u>	<u>3326</u>	<u>Delg.</u>

