

KANSAS


Form 51-5M-7-40-Palace

Rice

Section 25 Township 18 Range 8-W

Well No. 9 Lansing "B"

Company Continental et al
Geneseo Pool

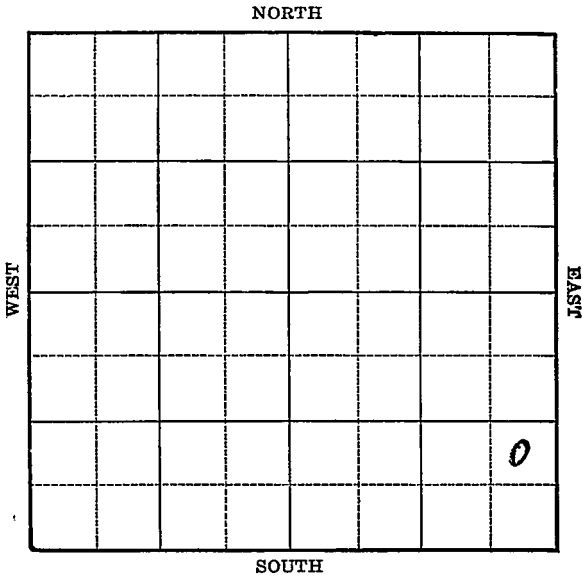

1941

4/9

Arb. 3206'

6" - 3178'

T.D. 3226'

79' of 4" perforated liner at
3226'

4000 acid.

Potential 431 bbls., pump.

40.1 Gravity

COMPLETED

Map No. 45 Sec. 25 Twp. 18 R. 8W

Well No. 9 Lansing "B"

Continental etal Company

Contractor

COMPLETED

SECTION PLAT

NE SE SE

_____ Ft. from N. Line

990 Ft. from S. Line

330 Ft. from E. Line

_____ Ft. from W. Line

GENESEO POOL

Location _____

Rig up _____

Drilling and Remarks:

Cr & 3206

6" @ 3178

79' of 4" Pipe set to bottom

3226.

4000 cu ft

Pump 4310 &

40' Gr

RECORD

Cased _____ in., _____ ft.

Sand _____

Gas _____

Oil _____

Total Depth 3226

PRODUCTION

1st 24 hrs. Nat. _____

1st 24 hrs. after shot _____

Gas _____ Cu. Ft.

Dry Hole _____

Abandoned _____

Date

APR 9 1941 19

S. J. LEWIS

Scout

W
O. W. P. B

S-513-A

CO. Rice ELEV. 1736DF
SEC. 25 TWP. 18 RGE. 8W
COMPANY Continental Oil No. 9

FIRST REPORT
COMPLETE

DEC 26 '57

FARM J. R. Lansing

(O.W.P.B.)

LOC. NE SE SE

Old Tops	
Lans	2799
Simp	3172
Arb	3206
OTD	3235

GEOL. O. W. P. B.

CONTR. _____

POOL Geneseo-Edwards

SPUD _____

OLD INFO: Spud 3/12/41
tops. 6" @ 3178, was Arb
prod then Simp prod.

NEW INFO: PPB 3134 1/2917

NS 20/2915-20 Bld 1

BWPH NS 2 hrs 20/2910.

15 Bld 2 BWPH NS 39/2895-2905 Bld. 2 1/2 BWPH
2 hrs 1000A to 2895-2920 Sb 20 BWPH NS 2 hrs

Plug 2880 2 1/4/2822-28 Bld 1/2 GWPH 4 h/4s. NS

250 mud acid 2000 A Sb 3 CO & 39 Gals Acid

wtr 10 hrs Acid 3000 P 1 1/2 BO & 1 1/2 BW 24 hrs

Complete Lans 2822-28.

CO. T

USE

NO

SEC.

TWP

RGE.