


Section 5 Township 12 Range 17W
Well No. #3 Clinton
Company Phillips

Bemis

NORTH

WEST

EAST

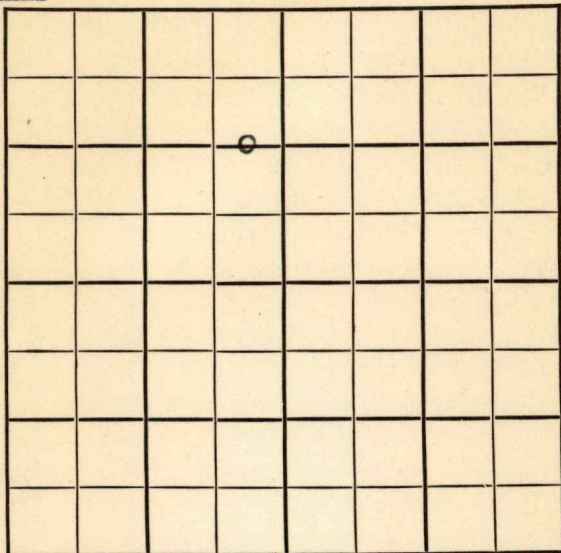

SOUTH

KANSAS

Ellis

Sec. 5 Twp. 12 R. 17W

Well No. #2 Clinton Farm

Phillips Company

Bemis Pool

1320 Ft. from N. Line


Ft. from S. Line

330

Ft. from E. Line

Ft. from W. Line

C E L NW

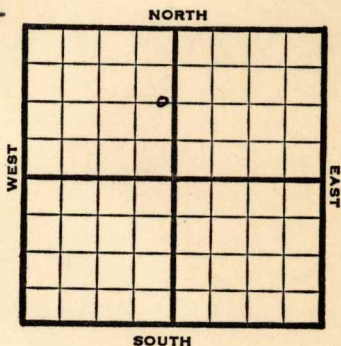

1947

Elev. 2133' REPORT

11/5

RUR

11/12

8" @ 1393'
2420' fsg.

11/19

"

11/25

Lansing 3360'
Arbuckle 3609'
TD 3642'
Run csg.

12/3

TD 3635'
Swb 7½ bbls oil, 1 hr.

12/10

TD 3661'

12/17

"

12/30

"

1948

1/7

Arb. 3609'
5" @ 3640'
Pump 63 oil & 134 W Pot.
Gr. 370
Total Depth 3661'

COMPLETED

Map No. 71 Sec. 5 Twp. 12 R. 17W

Well No. 3 Clinton

Phillips

Company

CORRECTION

Contractor

C E L NW

SECTION PLAT

1320 Ft. from N. Line

_____ Ft. from S. Line

330 Ft. from E. Line

_____ Ft. from W. Line

Ellis County

Location _____

Rig up _____

Drilling and Remarks:

Reported as

#2 Clinton

RECORD

Cased _____ in., _____ ft.

Sand _____

Gas _____

Oil _____

Total Depth _____

PRODUCTION

1st 24 hrs. Nat. _____

1st 24 hrs. after shot _____

Gas _____ Cu. Ft.

Dry Hole _____

Abandoned _____

Date

NOV 12 1947

19

S. J. LEWIS

Scout

Map No. 71 Sec. 5 Twp. 12 R. 17W

Well No. 3 Clinton

Phillips

Company

COMPLETE

Contractor

C E L NW


E12133
SECTION PLAT

1320 Ft. from N. Line

 Ft. from S. Line

330 Ft. from E. Line

 Ft. from W. Line

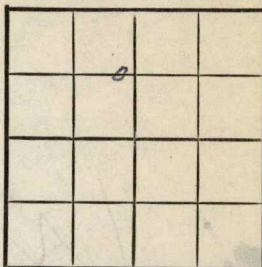

Ellis County

Location

Rig up

Drilling and Remarks:

Cu 43609

5" 23640

Pump 63016 + 134

W. Pat.

(27) 2 1/2

RECORD

Cased in., ft.

Sand

Gas

Oil

Total Depth 3661.

PRODUCTION

1st 24 hrs. Nat.

1st 24 hrs. after shot

Gas Cu. Ft.

Dry Hole

Abandoned

Date

JAN 7 1948 19

S. J. LEWIS

Scout

Map No. _____ Sec. 5 Twp. 12 R. 17W


Well No. 2 Clinton

Phillips Company

FIRST REPORT Contractor

C E L NW

SECTION PLAT

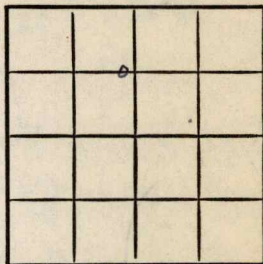

1320 Ft. from N. Line

_____ Ft. from S. Line

330 Ft. from E. Line

_____ Ft. from W. Line

Ellis County

Location _____

Rig up _____

Drilling and Remarks:

R U R

RECORD

Cased _____ in., _____ ft.

Sand _____

Gas _____

Oil _____

Total Depth _____

PRODUCTION

1st 24 hrs. Nat. _____

1st 24 hrs. after shot _____

Gas _____ Cu. Ft.

Dry Hole _____

Abandoned _____

Date

NOV 5 1947 19

S. J. LEWIS Scout