

KANSAS

Form 51-5M-7-40-Palace


Rice

Section 25 Township 18 Range 8-W

Well No. 8 Lansing "B"

Company Continental et al

NORTH Geneseo Pool

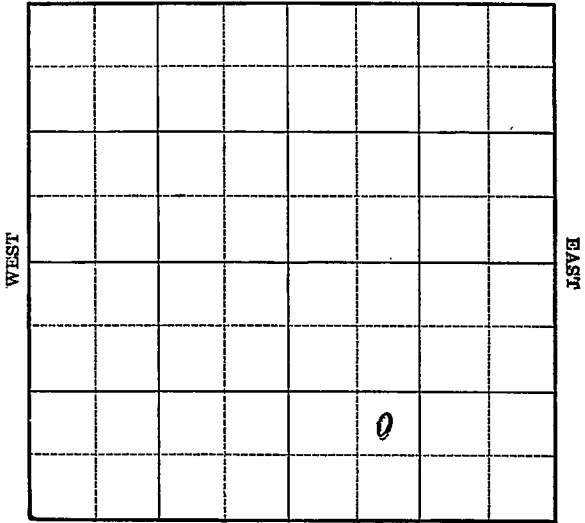

SOUTH

KANSAS Rice

Sec. 25 Twp. 18 R. 8-W

Well No. #8 Lansing "B" Farm

Continental et al Company

(Geneseo)


_____ Ft. from N. Line

990 Ft. from S. Line

_____ Ft. from E. Line

990 Ft. from W. Line

Elev. 1727

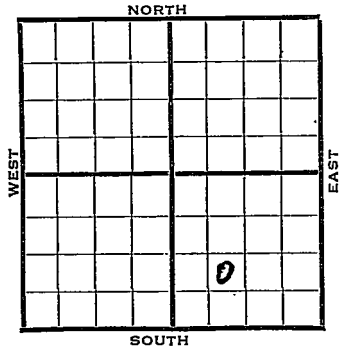

1941	REPORT
1/15	Derri ck.
1/23	"
1/29	10" - 210' Dr Ig. 1950'
2/6	Arb. 3129 - 37' T.D.
	7" - 3130' RUST.
2/13	T.D. 3192' 2900' oil.
2/19	Arb. 3129'
	7" - 3130'
	T.D. 3207'
	Echometer potential 6056 bbls.
	Maximum 3000 bbls.
	40.1 Gravity

COMPLETED

Map No. 45 Sec. 25 Twp. 18 R. 8W

Well No. 8 Lansing

Continental etal Company

Contractor

FIRST REPORT

SECTION PLAT

NE SW SE

_____ Ft. from N. Line

990 Ft. from S. Line

_____ Ft. from E. Line

990 Ft. from W. Line

			o

GENESEO POOL

Location _____

Rig up _____

Drilling and Remarks:
Derrick

RECORD

Cased _____ in., _____ ft.

Sand _____

Gas _____

Oil _____

Total Depth _____

PRODUCTION

1st 24 hrs. Nat. _____

1st 24 hrs. after shot _____

Gas _____ Cu. Ft.

Dry Hole _____

Abandoned _____

Date

JAN 15 1941

19

S. J. LEWIS

Scout

Map No. 45 Sec. 25 Twp. 18 R. 8WWell No. 8 Lansing "B"Continental etal

Company

CORRECTION

Contractor

SECTION PLAT

NE SW SE

_____ Ft. from N. Line

990 Ft. from S. Line

_____ Ft. from E. Line

990 Ft. from W. Line

GENESEO POOL

			o

Location _____

Rig up _____

Drilling and Remarks:

Reported as

#8 Lansing

RECORD

Cased _____ in., _____ ft.

Sand _____

Gas _____

Oil _____

Total Depth _____

PRODUCTION

1st 24 hrs. Nat. _____

1st 24 hrs. after shot _____

Gas _____ Cu. Ft.

Dry Hole _____

Abandoned _____

Date

JAN 2 1941

19

S. J. LEWIS

Scout

