


Section 25 Township 18 Range 8 W

Well No. # 9 Kimple

Company Continental Oil

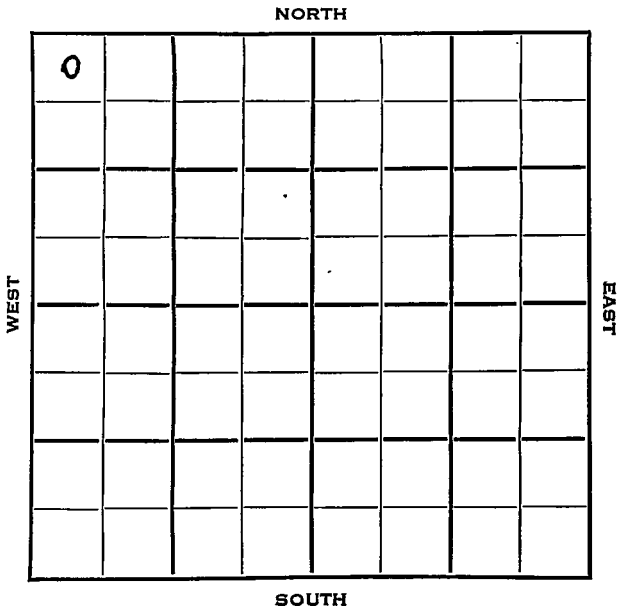

Rice

KANSAS ✓

Sec. 25 Twp. 18 R. 8W

Well No. #9 Kimple Farm

Continental Oil Company

Garvie Contractor

Geneseo Pool

NORTH


330 Ft. from N. Line

_____ Ft. from S. Line

_____ Ft. from E. Line

330 Ft. from W. Line

NW NW NW

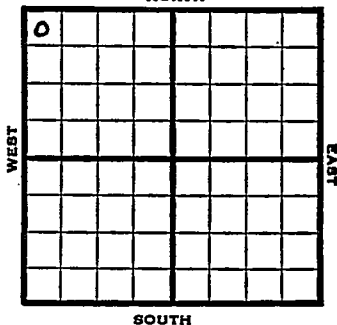

1953 Elev. 1743' REPORT

5/27 M I R

6/3 10" @ 332'
Arb 3234',
DST 3235-39 1/2 hr, 1560' oil 750#

6/10 RTD 3239
5" @ 3236'
CO 3239
S/ 7/4 BO 4 BW 4 Hrs. POP

7/1 Spud 5-26-53 Oil well TD 3239
10" @ 332
DST 3235-39 open 1/2 hr rec 1560' oil
750# TD 3239 5" @ 3236
CO to 3239 S/7/4 BO 4 BW 4 hrs.
Heeb 2677 Br. lime 2808' Lans 2840
Simp. 3184 Arb. 3235
Comp. 29 BOPD 4 BW

COMPLETED

County Rice State Kansas

Sec. 25 (Blk. Twp.) 18 (Sur. Rge.) 8W Map No.

Operator Continental Oil

Well No. 9 Farm Kimple

Elev. Location NW NW NW

0					

330 Ft. From N Line NW

330 Ft. From W Line Quarter

1st. Report MAY 27 1953

Completion

Remarks

Garvie - Contr.

Spudding Date

Drig. Data Genesee Pool

M I R

County Rice State Kansas

Sec. 25 (Blk. Twp.) 18 (Sur. Rge.) 8W Map No.

Operator Continental Oil

Well No. 9 Farm Kimble

Elev. 1743 Location NW NW NW

D					

330 Ft. From N Line NW

330 Ft. From W Line Quarter

1st. Report

Completion JUL 1 1953

Remarks Geneseo Pool

Garvie - Contr.

Spudding Date 5-26-53

Drlg. Data Oil well TD 3239

10" @ 332 DST 3235-39 open 1/2 hr.

Rec. 1560' oil 750# TD 3239 5" @ 3236

CO to 3239 S/ 74 bo 4 bw 4 hr.

Heeb. 2677 Br. lime 2808 Lans. 2840

Simp. 3184 Arb. 3235

Comp. 29 bopd 4 bw

J. G. McGEHEE