


Ellis

Map No. **KANSAS** Sec. 5 Twp. 12 R. 17^w

Well No. 1- Shuttz Farm
Texas Oil & Kelly Company

NORTH

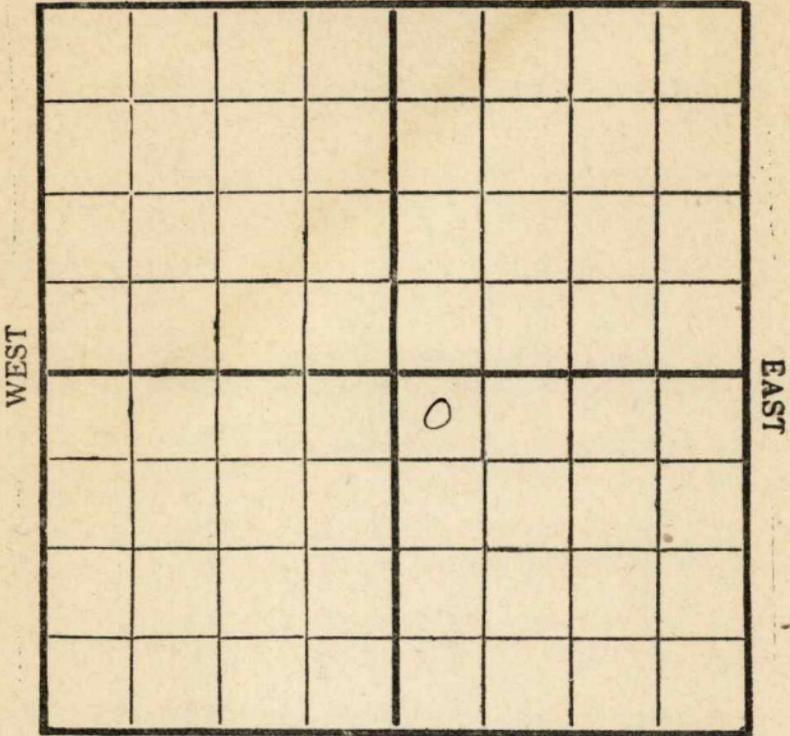

SOUTH

Location _____

Drilling Remarks _____

Rig Up _____

Drilling Remarks _____

RECORD

Cased _____ in. _____ ft.

Sand _____

Gas _____

Oil _____

Total Depth _____

PRODUCTION

1st 24 hrs. Nat. _____

1st 24 hrs. after shot _____

Gas _____ cu. ft. _____


Dry Hole _____

Abandoned _____

Map No. **KANSAS** Sec. 5 Twp. 12 R. 17^w

Well No. 1- Shults Farm

330 Ft. from N. Line
 _____ Ft. from S. Line
 _____ Ft. from E. Line
330 Ft. from W. Line

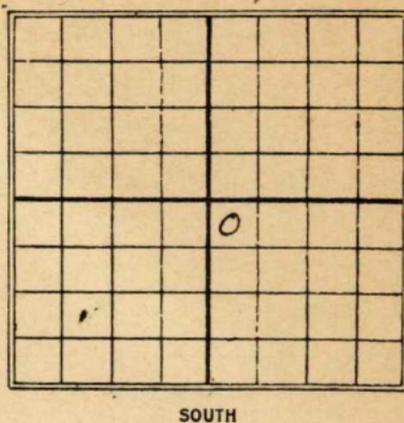

1930

Date	REPORT
3/12	Bldy Rig
3/19	Rigging up
3/26	hdlg 3410'
4/2	" 825'
4/9	" 1195'
4/16	" 1370'
4/23	" 1500'
4/30	" 1600'
5/7	" 2250'
5/14	2685 - Isq. bit
5/21	U.P. 8" - 2770'
5/28	hdlg. 2955'
6/4	" 3375'
6/11	" 3555'
6/18	hdlg. 3608-13 600' tail
6/25	Shot 20 gts - 3608 - 36' swab 40 bbls - hdlg. 3636'

(over)

7/2- Sand 3602-36'

TD. 3656

shot 20 qt

swab 462 bal

Comp.

Map No. **KANSAS** Sec. 5 Twp. 12 R. 17W

Well No. 1 Shutt

Texas Oil & Skelly Company

J Contractor

SECTION PLAT

330 Ft. from N. Line

..... Ft. from S. Line

..... Ft. from E. Line

330 Ft. from W. Line

		0	

FIRST REPORTS

Location.....

Rig up.....

Drilling and Remarks:

Building rig

RECORD

Cased..... in., ft.

Sand.....

Gas.....

Oil.....

Total Depth.....

PRODUCTION

1st 24 hrs. Nat.....

1st 24 hrs. after shot.....

Gas..... Cu. Ft.

Dry Hole.....

Abandoned.....

Date

MAR 12 1930

192

S. J. LEWIS Scout



Contractor

SECTION PLAT

330 Ft. from N. Line
____ Ft. from S. Line
____ Ft. from E. Line
330 Ft. from W. Line

		0	

COMPLETED

Location _____

Rig up _____

Drilling and Remarks:

shot 209 to.
swab 462886

RECORD

Cased _____ in., _____ ft.

Sand 3602-86

Gas _____

Oil _____

Total Depth 3656

PRODUCTION

1st 24 hrs. Nat. _____

1st 24 hrs. after shot _____

Gas _____ Cu. Ft.

Dry Hole _____

Abandoned _____

Date

JUL 2 1930

S. J. LEWIS Scout