

Map No. **KANSAS** Sec. 5 Twp. 12 R. 17 W.
 Well No. 1 - Shuttles Farm
Phillips Pet Company


NORTH

660 Ft. from N. Line

Ft. from S. Line

660 Ft. from E. Line

Ft. from W. Line

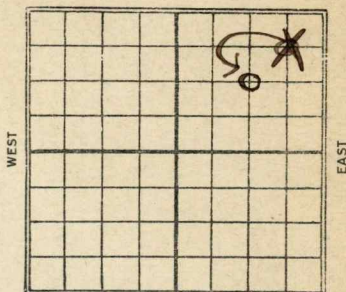

SOUTH

1928

Date

REPORT

7/11	Bldg Rig
7/18	Rig
7/25	Spud
8/1	
8/7	Drilg 425
8/15	" 720
8/22	" 1040
9/5	show gas 1100-1125
	2 Drilg 1150'
9/13	" 2300
9/19	" 2415'
9/26	" 2535'
10/3	run 8" - 2745'
10/10	T.D. 2920 U/R 8"
10/17	T.D. 3030' U/R 8"
10/24	2 Drilg 3285'
10/31	" 3510'
11/7	" 3516'
11/14	sand 3578-75'
	2000' oil 8 hrs - 32.5 gr
11/21	420 bbls storage
	filled up - SD - P.B.P.

11/28 420 bbls storage
filled up - SD-T.B.P.
12/5 swab 205 bbls 18 hrs
12/12 Gorham sand 3573-75'

T.D. 3575'

Swabbing 240 bbls.
Completed

Map No. KANSAS Sec. 5 Twp. 12 R. 17W

Well No. 1 Shutt

Phillips P. & S. Company

Contractor

SECTION PLAT

660 Ft. from N. Line

_____ Ft. from S. Line

660 Ft. from E. Line

_____ Ft. from W. Line

			0

FIRST REPORTS

Location _____

Rig up _____

Drilling and Remarks:

Building rig

RECORD

Cased _____ in., _____ ft.

Sand _____

Gas _____

Oil _____

Total Depth _____

PRODUCTION

1st 24 hrs. Nat. _____

1st 24 hrs. after shot _____

Gas _____ Cu. Ft.

Dry Hole _____

Abandoned _____

Date

JUL 11 1928

_____ 192 _____ S. J. LEWIS _____ Scout

Map No. KANSAS Sec. 5 Twp. 12 R. 17W

Well No. 1 Shuttles

Phillips P. & S. Company

Contractor

SECTION PLAT

1320 Ft. from N. Line

_____ Ft. from S. Line

1320 Ft. from E. Line

_____ Ft. from W. Line

Correction

Location _____

Rig up _____

Drilling and Remarks:

Reported
CNE NE
Should be
CNE

RECORD

Cased _____ in., _____ ft.

Sand _____

Gas _____

Oil _____

Total Depth _____

PRODUCTION

1st 24 hrs. Nat. _____

1st 24 hrs. after shot _____

Gas _____ Cu. Ft.

Dry Hole _____

Abandoned _____

Date

JUL 25 1928

192

S. J. LEWIS

Scout


MAP NO. 112P SEC. 5 TWP. 12 R. 17 W

WELL NO. 1 Shuttles

Phillips Pet COMPANY

CONTRACTOR

SECTION PLAT

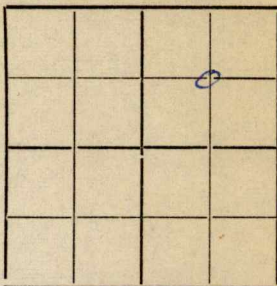

1320 FT. FROM N. LINE

FT. FROM S. LINE

1320 FT. FROM E. LINE

FT. FROM W. LINE

COMPLETED

RECORD

LOCATION _____

CASED _____ IN. _____ FT.

RIG UP _____

SAND _____

DRILLING AND REMARKS:

GAS _____

OIL _____

TOTAL DEPTH 3575

PRODUCTION

1ST 24 HRS. NAT. _____

1ST 24 HRS. AFTER SHOT _____

GAS _____ CU. FT.

DRY HOLE _____

ABANDONED _____

DATE

DEC 12 1928

192

S. J. LEWIS

SCOUT