

~~O.W.W.O. O.W.W.O.~~

KANSAS Rice

Section 25 Township 18 Range 8W

J.R.

Well No. 10 Lansing "B"


Company Continental

Geneseo Pool

NORTH

WEST

EAST

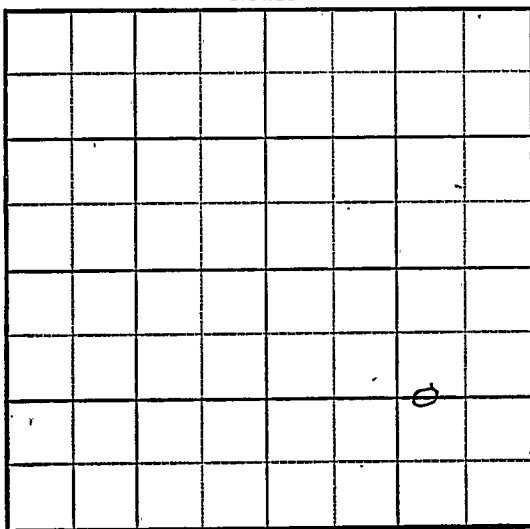

SOUTH

Rice

Sec. 25 Twp. O.W.W.O. R. 8W
Well No. J.R. #10 Lansing Farm

Continental Company
Geneseo Pool Lohman & Johnson Contr.


1420' Ft. from N. Line

1320 Ft. from S. Line

~~1000~~
~~990~~ Ft. from E. Line

Ft. from W. Line

C W L $E\frac{1}{2}$ SE

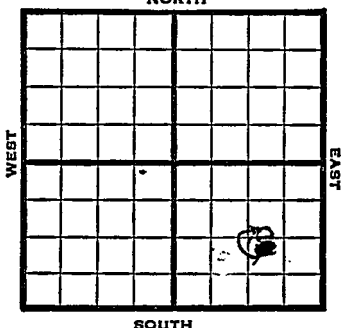

1948 | Eli 1710' : R E P O R T

10/27	Location
11/3	10" @ 387'

11/10 | Drlg. 2933'

11/16	Arbuckle 3201'
	TD 3247'
	7" @ 3247'

11/23	35 shots 3301-13 Swb 2 bbls oil PH 6 hrs. 1000 acid
-------	---

11/30	48 shots 2787-2796'
12/8	"

12/8	"
12/15	TD 3248'
	Lansing 2767'

Arb 3201'
7" @ 3247'
Perf Lans 2000 acid
Pump 66 oil / 2W Pot
33° Gr.

Clmp
COMPLETED

1953
11/4

O.W.V.
OWWO FOR SWDW
KC 2767', Arb 3201'
OTD 3250'
7" @ 3247'
to be SWD Well.

11/11 DD 3970', TD

11/18 NR

OVER

1953

10/16 NR

1954

1/6 NR

1/13 NR

1/20

SWD well TD 3970' KC 2767'
Arb. 3201' OTD 3250 7" @ 3247
DD 3970' Regan 3720'
Comp. for SWD well

ABANDONED

Map No. _____ Sec. 25 Twp. 18 R. 8W

Well No. 10 Lansing "B"

Continental Company

FIRST REPORT Contractor

C W L E $\frac{1}{2}$ SE


SECTION PLAT

1420 Ft. from N. Line

_____ Ft. from S. Line

990 Ft. from E. Line

_____ Ft. from W. Line

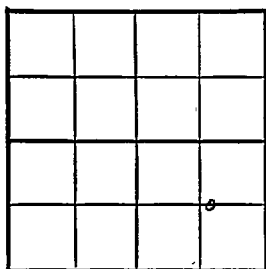

Rice County

Location X

Rig up _____

Drilling and Remarks:

RECORD

Cased _____ in. _____ ft.

Sand _____

Gas _____

Oil _____

Total Depth _____

PRODUCTION

1st 24 hrs. Nat. _____

1st 24 hrs. after shot _____

Gas _____ Cu. Ft.

Dry Hole _____

Abandoned _____

Date

OCT 27 1948

19

S. J. LEWIS

Scout


Map No. 45 Sec. 25 Twp. 18 R. 8WWell No. 10 Lansing "B"

Continental

Company

COMPLETE

Contractor

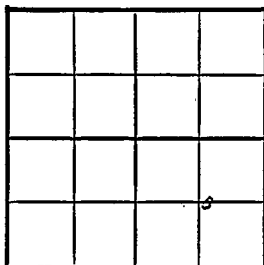C W L E $\frac{1}{2}$ SEE1.1710
SECTION PLAT1420 Ft. from N. Line Ft. from S. Line990 Ft. from E. Line Ft. from W. Line

Rice County

Location Rig up

Drilling and Remarks:

Lans 2767Cr 82017" C3247Perf 4 ans.2000 cu ftProd 66 oil 72WPer 330 cu

RECORD

Cased in., ft.Sand Gas Oil ✓Total Depth 3245

PRODUCTION

1st 24 hrs. Nat. 1st 24 hrs. after shot Gas Cu. Ft.Dry Hole Abandoned

Date


DEC 15 1948 19

S. J. LEWIS

Scout

O. W. D. D

County Rice State Kansas
 Sec. 25 (Blk. 18 (Sur. 8W Map No.
 (Twp.) (Rge.)
 Operator Continental Oil
 Well No. 10 Farm J. R. Lansing
 Elev. 1710 Location C W L E $\frac{1}{2}$ SE

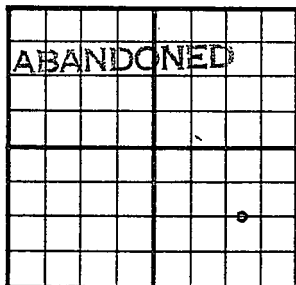

1320 Ft. From S Line SE
1000 Ft. From E Line Quarter

1st. Report

Completion JAN 20 1954Remarks (OWDD) For SWD**O. W. D. D**

Spudding Date

Drlg. Data SWD well TD 3970
KC 2767 Arb. 3201 OTD 3250
7" @ 3247 DD 3970 Regan 3720
Comp. for SWD well

J. G. McGEHEE