


Section 5 Township 12 Range 17W

Well No. 27 Shutts

Company Trans-Era Petr.

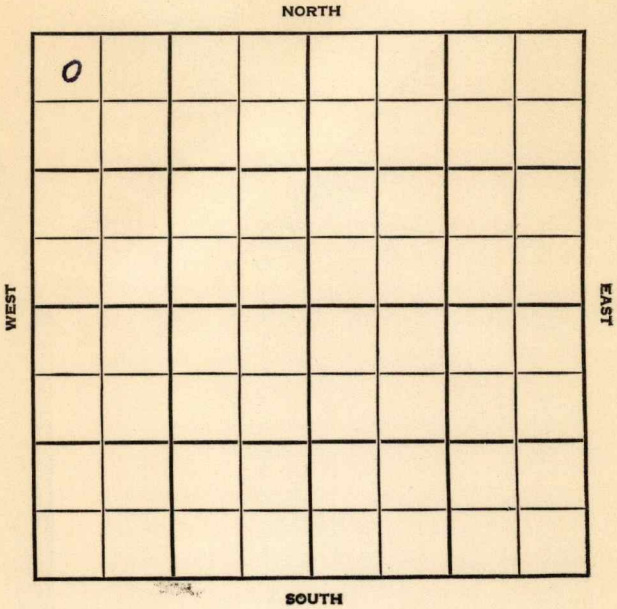

Ellis

KANSAS

SEC.	TWP.	R.
5	12	17W ✓

WELL NO. **3 Shutts** FARM

COMPANY **Trans-Era Pet**

CONTRACTOR


Bemis Shutts Pool

330 Ft. from N. Line

Ft. from S. Line

Ft. from E. Line

330 Ft. from W. Line

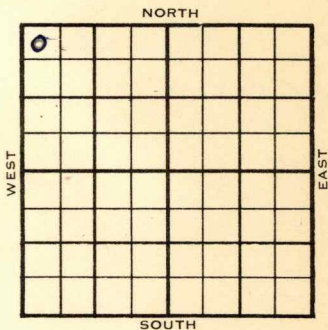

NW NW NW

1954

ELEVATION
Elev. 2100'

REPORT

6/2

8" @ 204'
Anhy 1530
Drlg. 2300

6/9

Top. 3060' **Heeb 3291'** **Tor 3311'**
Lans. 3334'
DST 3430-50, 1 hr, 15' M Off
Drlg. 3540'

6/15

Spud 5-28-54
D&A
TD 3688'
8" @ 204'
Anhy 1530', **Top 3060'**, **Heeb 3291'**,
tor 3311', **Lans 3334'**
DST 3430-50', opn 1 hr., rec. 15' mud,
Off
Arb. 3636'
TD 3688'
D&A

ABANDONED

County **Ellis** State **Kansas**

Sec. **5** (Blk.) **12** (Sur.) **17W** Map No.

Operator **Trans-Era Pgt.**

Well No. **3** Farm **Shutts**

Elev. Location **NW NW NW**

o					
FIRST REPORT					

330 Ft. From **N** Line **NW**

330 Ft. From **W** Line Quarter

1st. Report **JUN 2 1954**

Completion

Remarks

Spudding Date **5-28-54**

Drlg. Data **Bemis-Shutts Pool**

8" @ 204 **Anhy 1530** **drlg. 2300**

Kansas

Map No. _____ Sec. 5 Twp. 12 R. 17W

Well No. 2 Shutts

Trans-Era Company

CORRECTION Contractor

NW NW NW

SECTION PLAT

330 Ft. from N. Line

_____ Ft. from S. Line

_____ Ft. from E. Line

330 Ft. from W. Line

<u>0</u>			

Ellis County

Location _____

Rig up _____

Drilling and Remarks:

Reported
#3 Shutts

RECORD

Cased _____ in., _____ ft.

Sand _____

Gas _____

Oil _____

Total Depth _____

PRODUCTION

1st 24 hrs. Nat. _____

1st 24 hrs. after shot _____

Gas _____ Cu. Ft.

Dry Hole _____

Abandoned _____

Date

JUN 9 1954

J. G. McGEHEE

Scout

County Ellis State Kansas

Sec. 5 (Blk. 12) (Sur. 17W) Map No. 17W

Operator Trans-Era Pet.

Well No. 2 Farm Shutts

Elev. 2100 Location NW NW NW

0				

330 Ft. From N Line NW

330 Ft. From W Line Quarter

Ist. Report

Completion JUN 15 1954

Remarks Bemis-Shutts Pool

Spudding Date 5-28-54

Drlg. Data D & A TD 3688

8" @ 204 Anhy 1530 Top. 3060

Heeb. 3291 Tor. 3311 Lans. 3334

DST 3430-50 open 1 hr. Rec. 15' mud

0# Arb. 3636 TD 3688

D & A