


Rice KANSAS

DX 78-1

Section 25 Township 18 Range 8W

Well No. 11 S. Ainsworth

Company Conoco

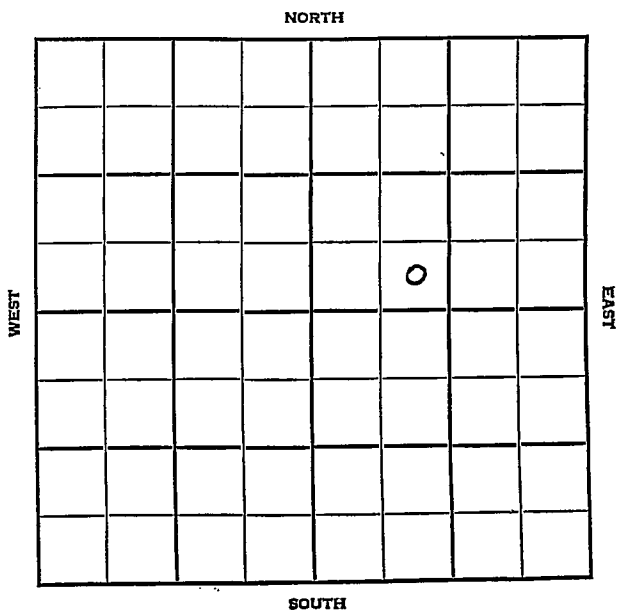

Rice KANSAS

SEC. 25	TWP. 18	R. 8W
WELL NO.		
11 S. Ainsworth		FARM
COMPANY		
Conoco		
CONTRACTOR		
Lohman & Johnson		


Geneseo-Edwards Pool

2310 Ft. from N. Line

_____ Ft. from S. Line

1650 Ft. from E. Line

_____ Ft. from W. Line

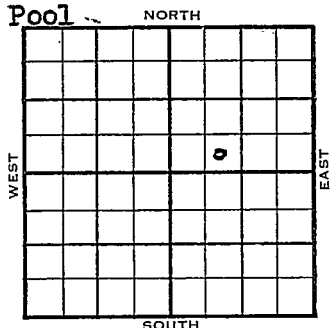

SE SW NE

	ELEVATION	REPORT
1954	1725	
6/23	Spdg. 6-16-54 8" @ 320 Coring @ 2773	
6/30	Br li 2731' Lans 2761' DST 2858-76, 1/2 hr, 400' o & GCM 50' GCM 975#.	
7/28	spdg 6-16-54 oil well TD 3207 8" @ 320 Freeb 2602 Br. Lime 2731 Lans. 2761 DST 2858-76 open 1/2 hr. Rec. 400' o & g 50' gcm 975# DST 3156-65 open 1/2 hr. Rec. 345' wtr 600# DST 3130-48 open 1/2 hr. Rec. 240' oil 30' ocm 51 off TD 3207 5" @ 3205 40/3128-38 1000 A S/ 11 bo 15 bwph 11 hr. 16/ 3153-57 Arb. 3128 500 A S/ 10 bo 1 hr. P/ 39 bo 73 bw 24 hr. P/ 41 bo 94 bwph Comp. 59 bwph 88 bw	

COMPLETED

J. G. McGEHEE

