FORM 51

Ellis KANSAS

Section 5 Township 12 Range 17w

Well No. 1 Treva

Company Phillips Petr.

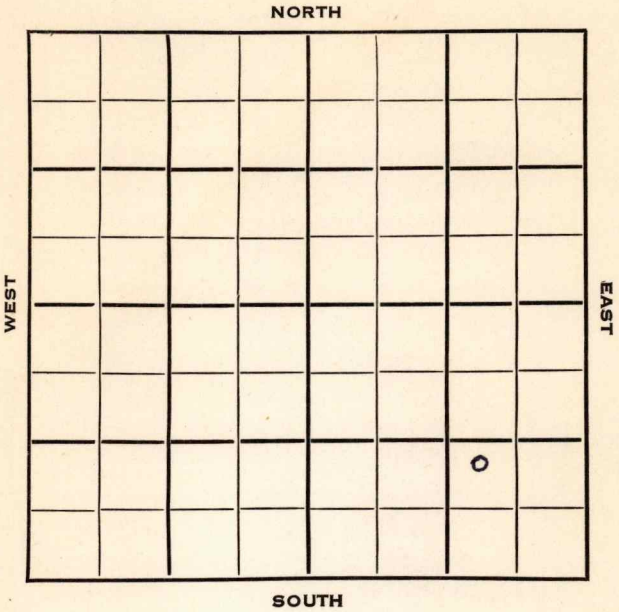

Ellis

KANSAS

SEC.	TWP.	R.
5	12	17W

WELL NO. #1 Trova FARM

COMPANY Phillips Pet.

CONTRACTOR

Bemis-Shutts Pool

NORTH

WEST EAST

SOUTH

_____ Ft. from N. Line

1140 Ft. from S. Line

990 Ft. from E. Line

_____ Ft. from W. Line

NW SE SE

1954	ELEVATION 2063' REPORT
4/14	Location
6/2	Spud 4-16-54 Oil Well TD 3608' 10" @ 1090' Howard 3004', Top 3030', Doug 3236', Lans 3275', B KC 3512' TD 3548' 7" @ 3545' DD 3577' B/18½ bo 12 hrs., 1000A S/19¼ bo 14 hrs. Arb. 3544' DD 3585' B/3 boph 3 hrs. DD 3608' S/5 boph 3 hrs. P/34 bo 9 hrs. P/58 bo 24 hrs. Comp.

COMPLETED

DX-78

FORM 275 FOR SALE BY KANSAS BLUE PRINT CO.

County Ellis State Kansas

Sec. 5 (Blk. / Twp.) 12 (Sur. / Rge.) 17W Map No.

Operator Phillips Pet.

Well No. 1 Farm Treva

Elev. Location NW SE SE

1140 Ft. From S Line SE

990 Ft. From E Line Quarter

1st. Report APR 14 1954

Completion

Remarks

Spudding Date

Bemis-Shutts Pool

FIRST REPORT

Drlg. Data

Location

J. G. McGEHEE

FORM 275 FOR SALE BY KANSAS BLUE PRINT CO.

County Ellis State Kansas

Sec. 5 (Blk. / Twp.) 12 (Sur. / Rge.) 17W Map No.

Operator Phillips Pet.

Well No. 1 Farm Treva

Elev. 2063 Location NW SE SE

1140 Ft. From S Line SE

990 Ft. From E Line Quarter

1st. Report

Completion JUN 2 1954

Remarks Bemis-Shutts Pool

Spudding Date 4-16-54

Drlg. Data Oil well TD 3608

10" @ 1090 Howard 3004 Top. 3030

Doug. 3236 Lans. 3275 B KC 3512

TD 3548 7" @ 3545 DD 3577 B/ 18½ bo

12 hr. 1000 A S/ 19¼ bo 14 hr.

Arb. 3544 DD 3585 B/ 3 boph 3 hr.

DD 3608 S/ 5 boph 3 hr. P/ 34 bo 9 hr.

P/ 58 bo 24 hr. Comp.

J. G. McGEHEE