

Rice KANSAS


DX 78-1

Section 25 Township 18 Range 8W

Well No. 12 J. R. Lansing

Continental Oil

Company _____

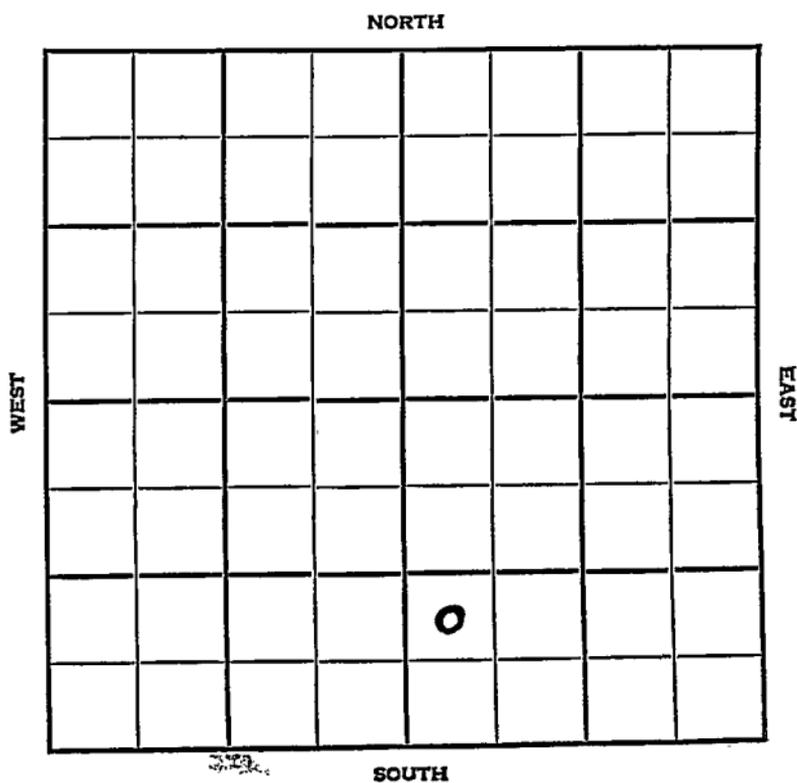

Rice KANSAS


SEC. 25	TWP. 18	R. 8W
-------------------	-------------------	-----------------

WELL NO. **12 J. R. Lansing** FARM

COMPANY **Continental Oil**

CONTRACTOR **Lohman & Johnson
Geneseo Pool**

_____ Ft. from N. Line
1030 _____ Ft. from S. Line
2310 _____ Ft. from E. Line
 _____ Ft. from W. Line

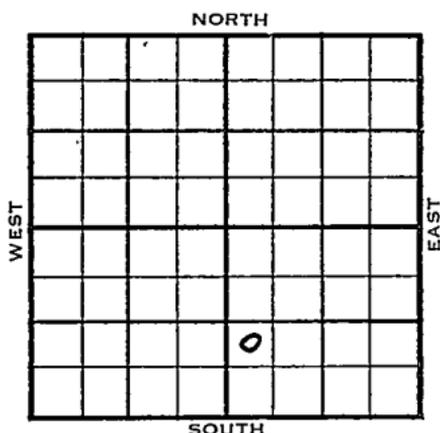

C NW SW SE Arb. test

1954	ELEVATION 1713'	REPORT
-------------	---------------------------	--------

8/4 Spdg 8-2-54
 8" @ 321
 WOC

8/25 Spud 8-2-54 - Oil Well
 TD 3127'
 8" @ 321'
 Heeb 2596', Br lime 2719', Lans 2750'
 DST 2869-85', opn 1 hr., rec. 80'
 muddy sw, 1080#
 Re-Arb. 3112', Arb. 3119'
 TD 3127'
 5" @ 3111'
 Schl Tops: Heeb 2594', Br lime 2717', Lans 2750', Arb. 3109'
 CO to 3127'
 S/9 bo 6 hrs., 5000A
 S/54 bo 108 bw 6 hrs.
 PB 3117'
 S/52 bo 60 bw 6 hrs., 500A
 omp. X 101 bopd 235 bw

COMPLETED

