


Section 5 Township 12 Range 17-W

Well Number 3 - Schutts

Company Phillips Pet.

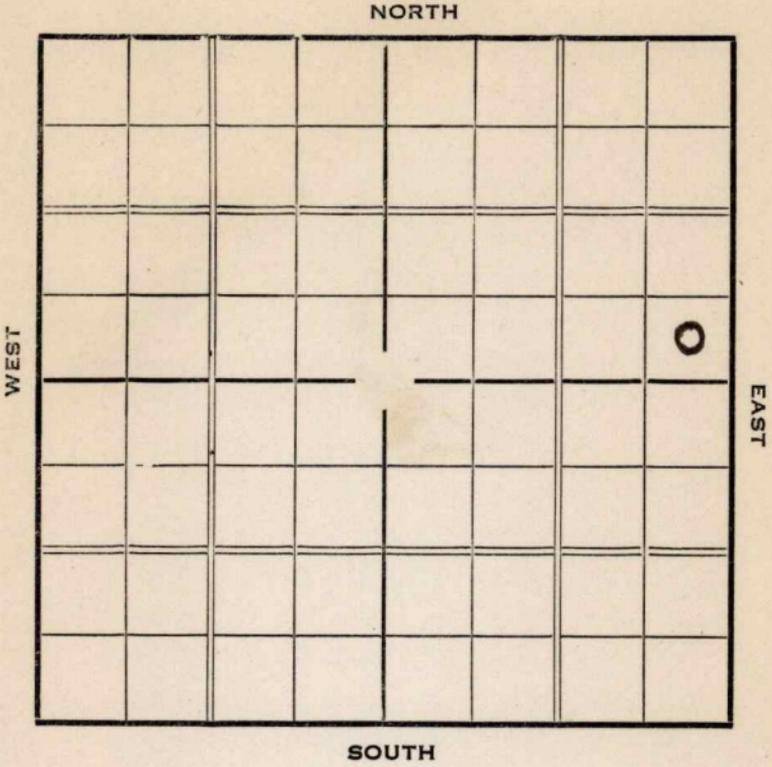

Sec. 5 Twp. 12 R. 17-W

Well No. #3 Schutts Farm


Phillips Petr. Company

 Ft. from N. Line

330 Ft. from S. Line

330 Ft. from E. Line

 Ft. from W. Line

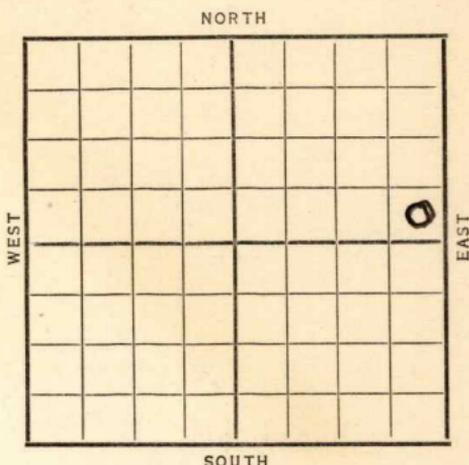

Elev. 2033

Date

REPORT

1937

5/12

Location

5/21

Drlg. 1100'.

5/28

Drlg. 2160'.

6/4

T.D. 2683'. C.O.

6/11

S. O. 3338-50'. Drlg. 3435'

6/19

Sil. 3494'. T.D. 3495'.

7" @ 3494'. RUST.

6/25

" " "

7/2

" " "

7/9

" " "

7/16

at 3499' swab 287 bbls. oil

& 16 bbls. water 24 hrs.

At 3503', 3200' water 1 hr.

Drlg. 3506'.

7/23

T.D. 3522'. Swab 40 bbls. &

120 bbls. water in 11 hrs.

7/30

" " " " "

8/6

" " " " "

8/13

" " " " "

8/20

Testing.

OVER

1937

8/28 P.B. 3474' SD.

9/3 Drilled to 3497' T.D.
2000 acid.
Pumped 197 bbls. 7 hrs.
10% water.

9/8 7" @ 3494'.
Sil. 3494'.
T.D. 3522'.
P.B. 3474 & drilled out
to T.D. 3497'.
2000 acid.
P. 123.18 bbls. 4 hrs.
121.48 bbls. 4 hrs.
Pot. 729 bbls. oil.
Plus 60% water.

COMPLETED

Ellis **KANSAS**

Map No. 71 Sec. 5 Twp. 12 R. 17^w

Well No. 3 - Schutte

Phillips Pet Company

Contractor

FIRST REPORT

SECTION PLAT

 Ft. from N. Line

330 Ft. from S. Line

330 Ft. from E. Line

 Ft. from W. Line

			0

Location ✓

Rig up

Drilling and Remarks:

RECORD

Cased in., ft.

Sand

Gas

Oil

Total Depth

PRODUCTION

1st 24 hrs. Nat.

1st 24 hrs. after shot

Gas Cu. Ft.

Dry Hole

Abandoned

Date

MAY 12 1937 19

H. D. Hatfield

Scout

Map No. _____ Sec. 5 Twp. 12 R. 17W

Well No. 3-Schutte

Phillips pet Company

Contractor _____

COMPLETED

SECTION PLAT

_____ Ft. from N. Line
330 Ft. from S. Line
330 Ft. from E. Line
_____ Ft. from W. Line

			0

Location _____

RECORD

Rig up _____

Cased 7 in., 3494 ft.
3494
Sand

Drilling and Remarks: _____

Gas _____
Oil _____
Total Depth 3522

P.B. 3474 + Drilled out
2000 acid To T.D. 3497

PRODUCTION

P. 123.18 4 hrs
121.48 " "

1st 24 hrs. Nat. _____
1st 24 hrs. after shot _____

Prod. 729 bbls oil

Gas _____ Cu. Ft.

Plus 60 gals water

Dry Hole _____

Abandoned _____

Date

SEP 8 1937

19

H. D. Hatfield

Scout